


Section 11 Township 28 Range 21WWell No. #1 KirkpatrickCompany W.J. Coppinger et al

NORTH

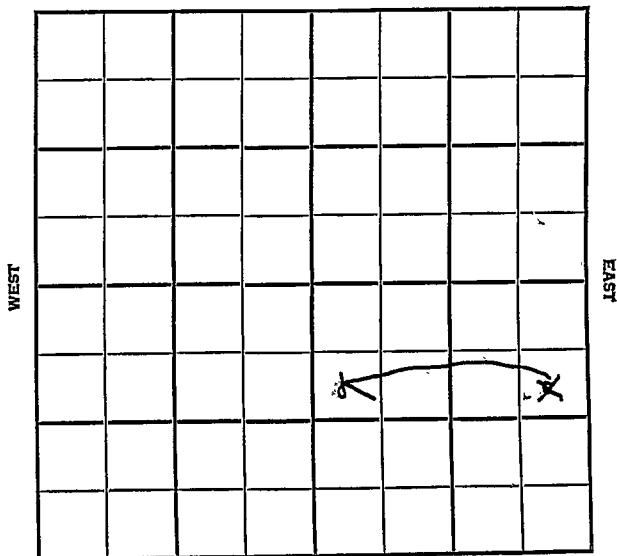

SOUTH

Ford

KANSAS

SEC.	TWP.	R.
11	28	21 W

WELL NO.

1 Kirkpatrick

FARM

COMPANY

W. J. Coppinger et al

CONTRACTOR

Coppinger


S. Pleasant Valley P^{NORTH}~~1250~~ Ft. from N. Line

1450 Ft. from S. Line

~~330~~ Ft. from E. Line

330 Ft. from W. Line

~~SE NE SE~~
SW NW SE

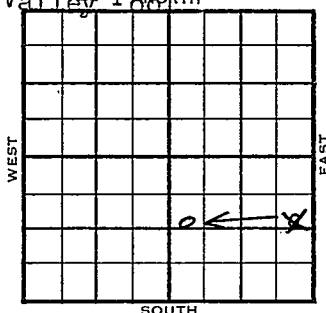

ELEVATION

REPORT

1954 2351'

8/18

Spud 8-12-54

8" @ 325

Drlg. 950'

12/1

Spud 8-12-54 SI gas well

TD 5060' 8" @ 325 Anhy 1355

Miss. 4960

DST 4971-5001, gas in 1½ min,

3,500,000 CFG, 5' gassy SW 1020#

DST 4974-5020½ gas in 1½ min,

3,785,000 CFG 855#

Heeb 4145 Lans 4304

DST 5030-60, open 50 min, rec 5' mud

755# TD 5060 5" @ 5059 CO to

5044 8/5033-35 5 GW 1 hr. SP 5028

48/5002-14 40/4986-96 500 A

3000 A Comp. shut in gas well

3,800,000 CFGPD 400#

COMPLETED

Kansas

Map No. _____ Sec. 11 Twp. 28 R. 21WWell No. 1 Kirkpatrick_____
W. J. Coppinger et al. Company_____
CORRECTION Contractor

SW NW SE

SECTION PLAT

		o	

Ft. from N. Line1450 Ft. from S. Line_____
Ft. from E. Line330 Ft. from W. Line

Ford County

Location _____

Rig up _____

Drilling and Remarks:

Reported
SE NE SE

RECORD

Cased _____ in., _____ ft.

Sand _____

Gas _____

Oil _____

Total Depth _____

PRODUCTION

1st 24 hrs. Nat. _____

1st 24 hrs. after shot _____

Gas _____ Cu. Ft.

Dry Hole _____

Abandoned _____

Date

AUG 18 1954**FABEN GILSTRAP**
Scout

County **Ford** State **Kansas**Sec. **11** (Blk.) **28** (Sur.) **21W** Map No.Operator **W. J. Coppinger et al.**Well No. **1** Farm **Kirkpatrick**Elev. Location **SE NE SE**

FIRST REPORT

See Completion


0

1250 Ft. From **N** Line **SE****330** Ft. From **E** Line Quarter1st. Report **AUG 18 1954**Remarks *See Completion*

Remarks

Coppinger - Contr.Spudding Date **8-12-54**Drig. Data **S. Pleasant Valley Pool****8" @ 325 drlg. 950****FABEN GILSTRAP**

County Ford State Kansas
 Sec. 11 (Blk. 28 (Sur. 21W Map No. 1 Twp. 28 (Sur. 21W Rge. 1)
 Operator W. J. Coppinger et al.
 Well No. 1 Farm Kirkpatrick
 Elev. 2351 Location SW NW SE

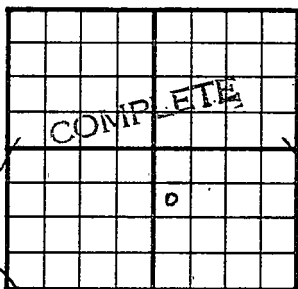

1450 Ft. From S Line SE
330 Ft. From W Line Quarter
 1st. Report
 Completion DEC 1 1954
 Remarks S. Pleasant Valley
Coppinger - Contr.
 Spudding Date 8-12-54

Drilg. Data SI gas well TD 5060
8" @ 325 Anhy 1355 Miss. 4960
DST 4971-5001 gas in 1½ min. 3,500,000
cfg 5' gassy sw 1020# DST 4974-5020
gas in 1½ min. 3,785,000 cfg 855#
Heeb. 4145 Lans. 4304 DST 5030-60
open 50 min. Rec. 5' mud 755#
TD 5060 5" @ 5059 CO to 5044
8/, 5033-35 5 gw 1 hr. SP 5028
48/ 5002-14 40/ 4986-96 500 A
3000 A Comp. shut in gas well
3,800,000 cfgpd 400#

FABEN GILSTRAP