


Section 11 Township 28 Range LOW

Well No. #1 Plummer

Company W. E. Bakke

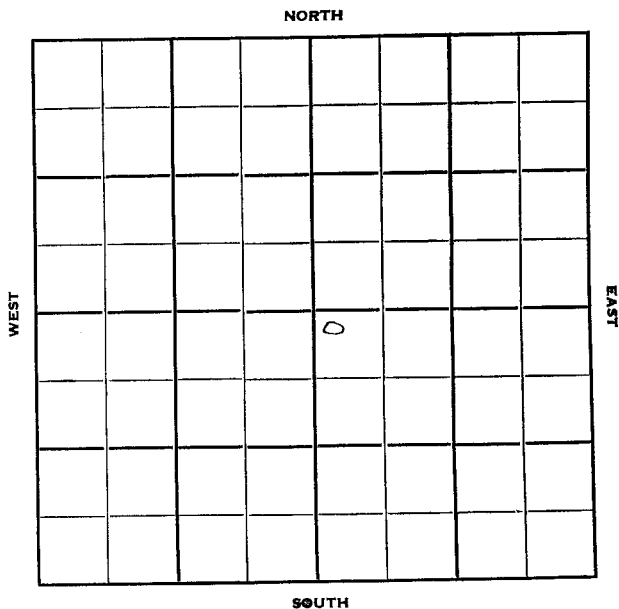

Stanton

KANSAS

Sec. 11 Twp. 28 R. 40 W

Well No. # 1 Plummer Farm

W. E. Bakke Company

Contractor

Hugoton Pool


150 Ft. from N. Line

Ft. from S. Line

Ft. from E. Line

150 Ft. from W. Line

NW NW SE

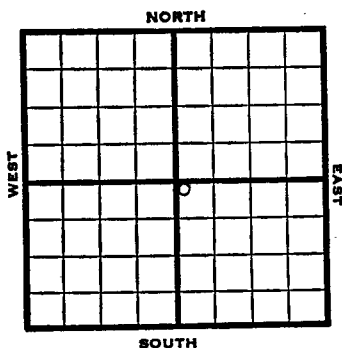


1951 3235' REPORT

8/29 Spud 8-20-51
10" @ 410' 7" @ 2248' RTD 2260'
DD 2393' 16,000 A Krider 2262'

10/10 Gas well TD 2393
10" @ 410 7" @ 2248 TD 2393
Kri. 2262'
16000 A Comp. 5,200,000 gas

COMPLETED

County Stanton State Kansas
 Sec. 11 (Blk. 28 (Sur. 40W Map No.
 (Twp.) (Rge.)
 Operator W. E. Bakke
 Well No. 1 Farm Plummer
 Elev. Location NW NW SE

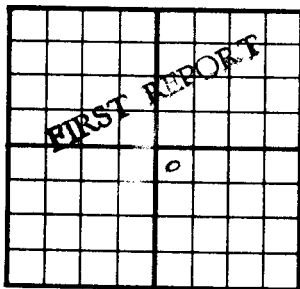

150 Ft. From N Line SE
150 Ft. From W Line Quarter

1st. Report AUG 28 1951

Completion

Remarks

Spudding Date 8-20-51

Drig. Data

Hugoton Pool

10" @ 410 7" @ 2248 RTD 2260

DD 2393 16000 A Krider 2262

J. E. TYRA

