


Pratt

KAV 5

Section 11 Township 28 Range 15-W

Well No. 1 Rice

Company Atlantic Refining

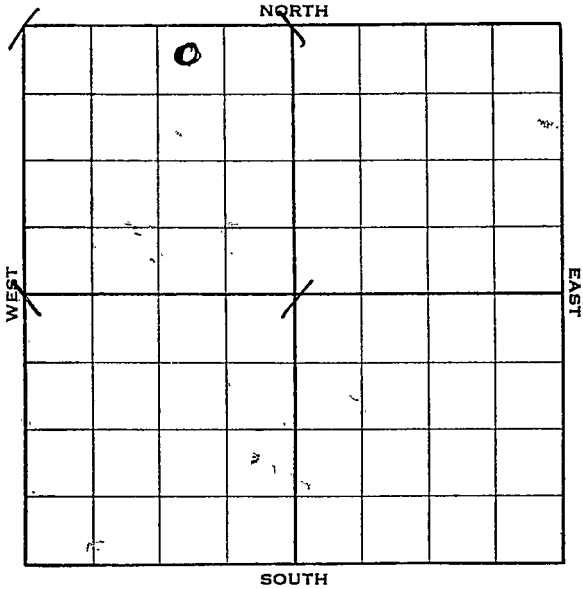

Sec. 11 Twp. 28 R. 15-W

Well No. #1 Rice Farm

Atlantic Refg. Company


330 Ft. from N. Line

\_\_\_\_\_ Ft. from S. Line

990 Ft. from E. Line

\_\_\_\_\_ Ft. from W. Line

Elev. 2055

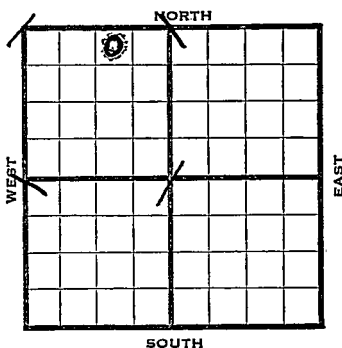

1938	REPORT
3/23	Location
4/1	"
4/8	B.R.R.
4/15	13" @ 339'. T.D. 344'. WOC.
4/22	Anhy 903'. Drlg. 2710'.
4/29	Drlg. 3995'.
5/6	Lans. 4019-4356'.
	Miss. 4525'. Drlg. 4558'.
	No shows.
5/12	Viola 4566'. Simp. shale 4649'.
	Arb. 4714'. Coring 4736'.
	No shows.
5/18	Arb. 4714'.
	T.D. 4861'.
	No oil.
	Show water.
	ABANDONED

Map No. 97 Sec. 11 Twp. 28 R. 15WWell No. 1 RiceAtlantic Refining Company

Contractor

## FIRST REPORT

NW NE NW

330 Ft. from N. Line

\_\_\_\_\_ Ft. from S. Line

990 Ft. from E. Line

\_\_\_\_\_ Ft. from W. Line

**Special**

## SECTION PLAT

	o	.	

Location X

Rig up \_\_\_\_\_

Drilling and Remarks:

## RECORD

Cased \_\_\_\_\_ in., \_\_\_\_\_ ft.

Sand \_\_\_\_\_

Gas \_\_\_\_\_

Oil \_\_\_\_\_

Total Depth \_\_\_\_\_

## PRODUCTION

1st 24 hrs. Nat. \_\_\_\_\_

1st 24 hrs. after shot \_\_\_\_\_

Gas \_\_\_\_\_ Cu. Ft.

Dry Hole \_\_\_\_\_

Abandoned \_\_\_\_\_

Date

MAR 23 1938

19

H. D. Hatfield

Scout

Pratt

KANSAS

Map No. 92 Sec. 11 Twp. 28 R. 15WWell No. 1 RiceAtlantic Refining Company

Contractor

ABANDONED

## SECTION PLAT

NW NE NW  
330 Ft. from N. Line

\_\_\_\_\_ Ft. from S. Line

990 Ft. from E. Line

\_\_\_\_\_ Ft. from W. Line

	0		

Location \_\_\_\_\_

Rig up \_\_\_\_\_

Drilling and Remarks:

No oil  
show wt

DVA

## RECORD

Cased \_\_\_\_\_ in., \_\_\_\_\_ ft.

Sand Arb 4714

Gas \_\_\_\_\_

Oil \_\_\_\_\_

Total Depth 4861

## PRODUCTION

1st 24 hrs. Nat. \_\_\_\_\_

1st 24 hrs. after shot \_\_\_\_\_

Gas \_\_\_\_\_ Cu. Ft.

Dry Hole \_\_\_\_\_

Abandoned \_\_\_\_\_

Date

MAY 18 1938

19

H. D. Hatfield Scout