
FORM 51 5M BRIX KANSAS Grant

Section 12 Township 28 Range 37W

Well No. #1 Kuhn

Company Pan Handle Eastern

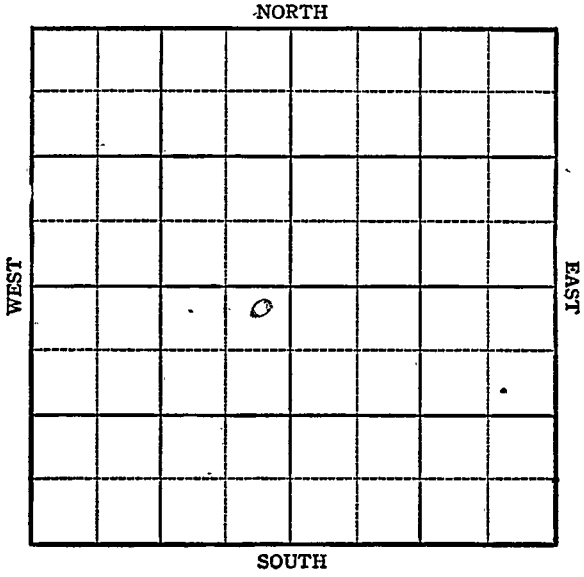

FORM 252-A
5M 3-44 PETROL

KANSAS

Grant

Sec. 12 Twp. 28 R. 37W

Well No. #1 Kuhn Farm

Pan Handle Eastern Company

Hugoton


200' Ft. from N. Line

Ft. from S. Line

200' Ft. from E. Line

Ft. from W. Line

Elev. 3004

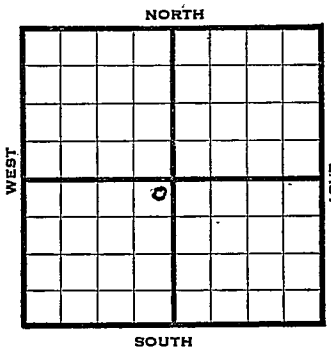

1944	REPORT
6/21	Location
6/28	10" @ 585 WOC
7/12	7" @ 2338 RUST
7/19	" " " "
7/26	" " " "
8/2	7" @ 2338 RUST
8/9	" " " "
8/16	" " " "
8/23	TD 2770 1½ M Gas PB
8/30	" " " " " "
9/8	268' of 5½" liner @ 2550
9/13	" " " " " "
9/21	" " " " " "
9/28	" " " " " "
10/4	" " " " " "
10/11	" " " " " " "
10/18	" " " " " "
10/25	" " " " " "
11/1	" " " " " "
11/8	" " " " " " "
11/16	" " " " "
11/24	" " " " "
11/29	" " " " " " "
12/6	" " " " "
12/14	" " " " " "
12/21	" " " " " "
12/29	" " " " " "

OVER

1945

1/3 268 6½" liner 550

1/10 13,500 acid

1/17 7" @ 2338
268' of 5½" liner @ 2550
,3500 acid
7,654,000 Gas
TD 2770
408# R Pr.

COMPLETED

FORM [illegible] 200 BKS 1 44 PETROL

KANSAS

Pool Name Hugoton

Map No. N M Sec. 12 Twp. 28 R. 37W


Well No. 1 Kuhn

Pan Handle Eastern Company

FIRST REPORT Contractor

NE SW

SECTION PLAT

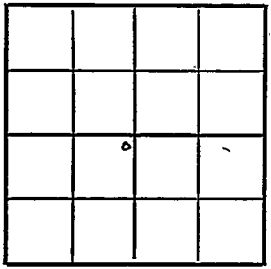

200 Ft. from N. Line

Ft. from S. Line

200 Ft. from E. Line

Ft. from W. Line

Grant County

Location X

Rig up

Drilling and Remarks:

RECORD

Cased in., ft.

Sand

Gas

Oil

Total Depth

PRODUCTION

1st 24 hrs. Nat.

1st 24 hrs. after shot

Gas Cu. Ft.


Dry Hole

Abandoned

Date

JUN 2 1 1944 19

S. J. LEWIS Scout

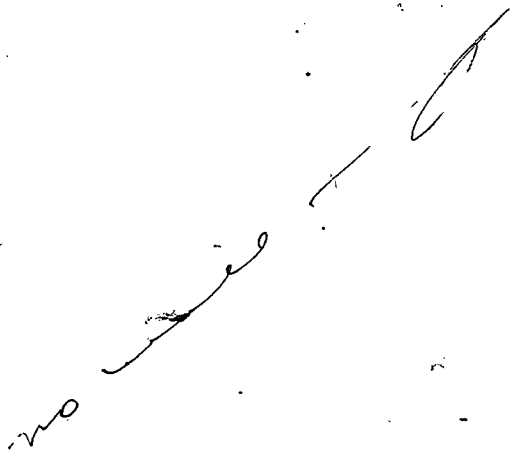

Misc. Small Maps No Small Map Ona
Cards Betty
Tracing
France Map
Scarborough Map
Moody Map
Geological Dept.
Moody Plat Book

FORM 26 200 BKS. 1 44 PETROL

KANSAS

Pool Name Hugoton Pool

Map No. Sec. 12 Twp. 28 R. 37 W


Well No. 1 Kuhn

Pan Handle Eastern Company

COMPLETED Contractor

NE SW

SECTION PLAT

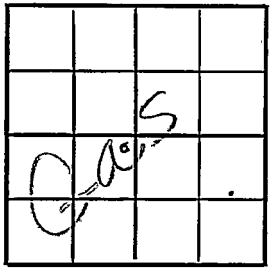

200 Ft. from N. Line

Ft. from S. Line

200 Ft. from E. Line

Ft. from W. Line

Grant

Location

Rig up

Drilling and Remarks:

7" @2398

268' of 5½ liner

@2550

18000 Coal

7,643,000 Gas

408# RP

RECORD

Cased in., ft.

Sand

Gas

Oil

Total Depth 2770

PRODUCTION

1st 24 hrs. Nat.

1st 24 hrs. after shot

Gas Cu. Ft.

Dry Hole


Abandoned

Date

JAN 17 1945 19

S. J. LEWIS Scout

no well map

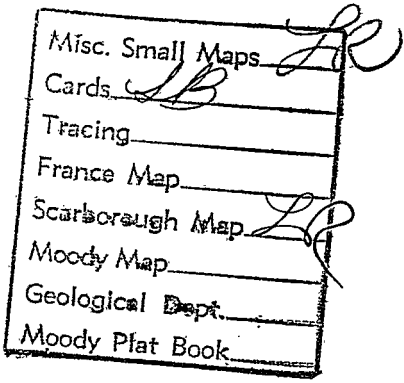
Misc. Small Maps
Cards
Tracing
France Map
Scarborough Map
Moody Map
Geological Dept.
Moody Plat Book