

KANSAS

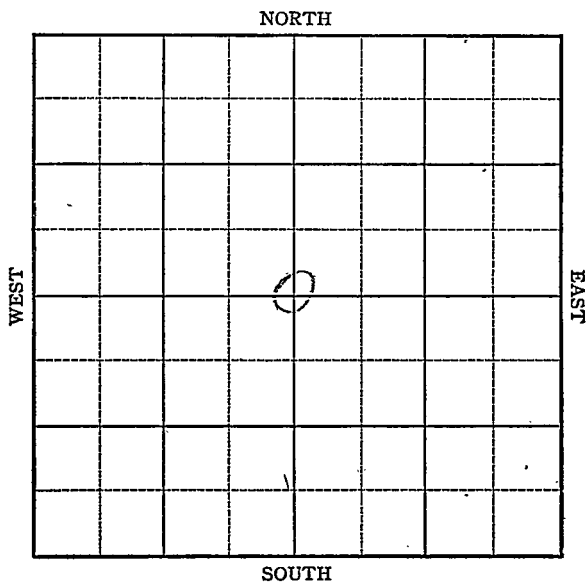
FORM 51 5M 6-46 PETROL

Haskell County

Section 12 Township 28 Range 33W

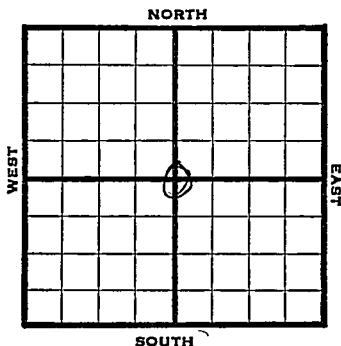
Well No. 1 cox

Company Stanolind



Sec. 12 Twp. 28 R. 33WWell No. #1 Cox Farm
Stanolind Company

Hugoton

2640 Ft. from N. Line Ft. from S. Line2640 Ft. from E. Line Ft. from W. Line

C Sec.

1946

2960

REPORT

8/7 Location
8/13 8" @ 780 WOC
8/20 Drlg 2672'
8/27 TD 2777'
5" @ 2743 RUST
9/5 250 acid
9/10 5000 acid
139 shots 2681-2724
8500 acid
9/18 5" @ 2743'
Perf.
Acid 15,000
4,206,000 Gas
TD 2777'

COMPLETED

KANSAS

Kansas Pool Name HugotonMap No. _____ Sec. 12 Twp. 28 R. 33WWell No. 1 CoxStanolind CompanyFIRST REPORT Contractor

C Sec.

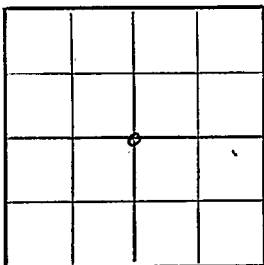
SECTION PLAT

2640 Ft. from N. Line

_____ Ft. from S. Line

2640 Ft. from E. Line

_____ Ft. from W. Line

Haskell County

RECORD

Location X

Cased _____ in., _____ ft.

Rig up _____

Sand _____

Drilling and Remarks:

Gas _____

Oil _____

Total Depth _____

PRODUCTION

1st 24 hrs. Nat. _____

1st 24 hrs. after shot _____

Gas _____ Cu. Ft.

Dry Hole _____

Abandoned _____

Date

AUG 7 1946 19S. J. LEWIS Scout

KANSAS Kansas Pool Name Hugoton PoolMap No. _____ Sec. 12 Twp. 28 R. 33WWell No. 1 CoxStanolind

Company

COMPLETED

Contractor

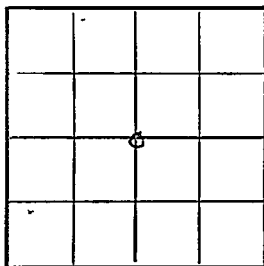
C Sec.

E/2960
SECTION PLAT2640 Ft. from N. Line

_____ Ft. from S. Line

2640 Ft. from E. Line

_____ Ft. from W. Line

Haskell County

Location _____

Rig up _____

Drilling and Remarks:

5' @ 2748Perf.15000 acub4206000 Gas**RECORD**

Cased _____ in., _____ ft.

Sand _____

Gas _____

Oil _____

Total Depth 2277**PRODUCTION**

1st 24 hrs. Nat. _____

1st 24 hrs. after shot _____

Gas _____ Cu. Ft.

Dry Hole _____

Abandoned _____

Date

SEP 1 8 1946

19

S. J. LEWIS

Scout