


Section 12 Township 28 Range 40W

Well No. #1 Richards

Company Champlin

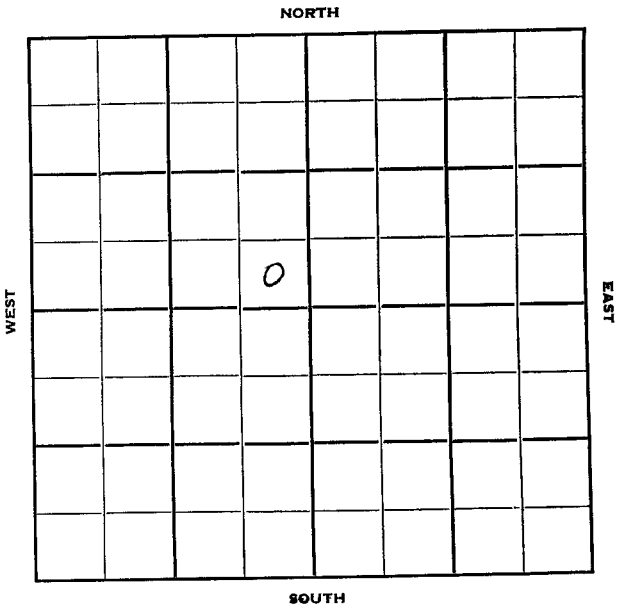

Sec. 12 Twp. 28 R. LOW

Well No. #1 Richards Farm

Champlin Company

Contractor


\_\_\_\_\_ Ft. from N. Line

330 Ft. from S. Line

330 Ft. from E. Line

\_\_\_\_\_ Ft. from W. Line

SE SE NW

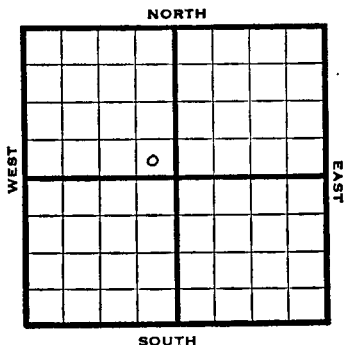

1951

Elev. 3226

REPORT

10/31

Spud 10-17-51

10" @ 431'

Her 2234'

Win 2318'

Kri 2248'

Ft. Riley 2382'

RTD 2461

7" @ 2461'

1952

1/9

Spud 10-17-51

Gas Well TD 2461

10" @ 431

Heb. 2234'

Kri. 2248

Win. 2318

Ft. Riley 2382

TD 2461

7" @ 2461 CO to 2460

138/ 2435-55

132/2385/2407

168/ 2318-46

108/ 2272-94

36000 A

Comp. 3,676,000 gas

**COMPLETED**

County **Stanton** State **Kansas**

Sec. **12** (Blk. Twp.) **28** (Sur. Rge.) **40W** Map No.

Operator **Champlin**

Well No. **1** Farm **Richards**

Elev. Location **SE SE NW**


**330** Ft. From **S** Line **NW**

**330** Ft. From **E** Line Quarter

1st. Report **OCT 31 1951**

Completion

Remarks

Spudding Date **10-17-51**

Orlg. Data

**10" @ 431 Her 2234 Kri 2248 Win 2318**

**Ft. Riley 2382 RTD 2461 7" @ 2461**

**J. E. TYRA**

