

KANSAS

Form 51—5M—7-40—Palace


Pratt

Section 12 Township 28 Range 11-W

Well No. #1 Kemp

Company Beardmore

NORTH Cunningham Pool

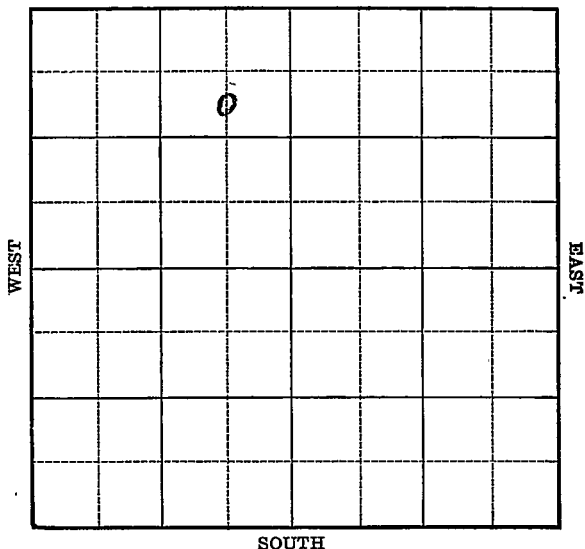


Sec. 12 Twp. 28 R. 11-WWell No. #1 Kemp FarmBeardmore Company

(Cunningham)

990 Ft. from N. Line Ft. from S. Line360 Ft. from E. Line Ft. from W. Line

Elev. 1751

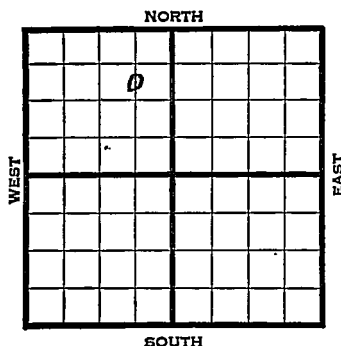

1940	REPORT
10/9	Derrick.
10/17	Drlg. 372'
10/24	Drlg. 1870'
10/31	Lans. 3525' Drlg. 3720'
11/7	Viola 4247-50' T.D. 5" - 4250'
	RUST.
11/14	"
11/21	T.D. 4260' Flow 110 bbls. in
	6 hrs. Run tubing.
11/27	Shut down.
12/5	" "
12/11	Viola 4247'
	5" - 4250'
	T.D. 4260'
	500 acid.
	Potential 2940 bbls., flow,
	plug 2% water.
	34.5 Gravity
	COMPLETED

Map No. 54 Sec. 12 Twp. 28 R. 11WWell No. 1 KempBeardmore

Company

Contractor

FIRST REPORT

C S L NE NW

990 Ft. from N. Line Ft. from S. Line660 Ft. from E. Line Ft. from W. Line

CUNNINGHAM POOL

SECTION PLAT

	o		

Location Rig up

Drilling and Remarks:

Derrick

RECORD

Cased in., ft.Sand Gas Oil Total Depth

PRODUCTION

1st 24 hrs. Nat. 1st 24 hrs. after shot Gas Cu. Ft.Dry Hole Abandoned

Date

OCT 9 1940 19S. J. LEWIS Scout

Map No. 54 Sec. 12 Twp. 28 R. 11WWell No. 1 KempBeardmore Company

Contractor

COMPLETED

C S L NE NW

990 Ft. from N. Line Ft. from S. Line660 Ft. from E. Line Ft. from W. Line

CUNNINGHAM POOL

SECTION PLAT

	6		

Location Rig up

Drilling and Remarks:

*Viola #247**5" @ 4250**500 acid**Flow 2940 psf
#2 7/8 W.**34 5/8***RECORD**Cased in., ft.Sand Gas Oil Total Depth 4260**PRODUCTION**1st 24 hrs. Nat. 1st 24 hrs. after shot Gas Cu. Ft.Dry Hole Abandoned

Date

DEC 11 1940S. J. LEWIS Scout