



12-28-13W

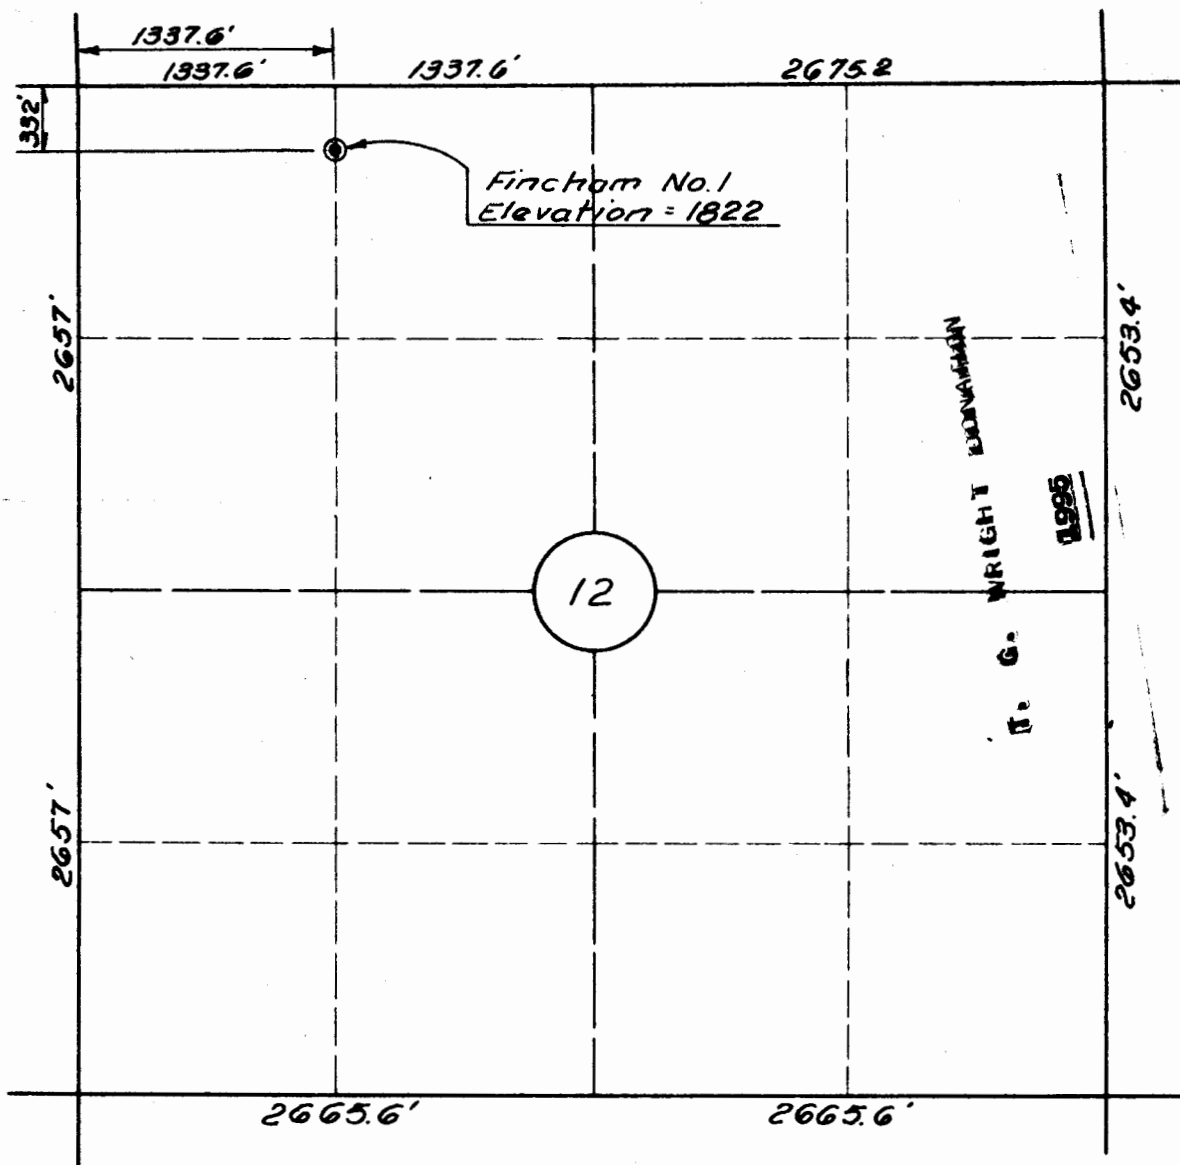

WELL DESCRIPTION

FINCHAM No. 1: N $\frac{1}{2}$, N $\frac{1}{2}$, of the Northwest Quarter, Section 12, Township 28 South, Range 13 West of the Sixth Principal Meridian, located in Pratt County, Kansas.

I, Paul E. Nixon, a Licensed Professional Engineer in the State of Kansas, do hereby certify that the survey as shown hereon was completed under my supervision on the 24th day of September, 1966, and is true and correct to the best of my knowledge.

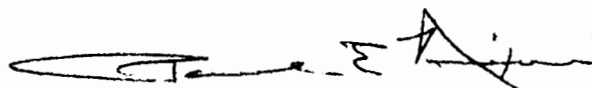
Paul E. Nixon, P.E.

REV. NO.	DATE	REVISION	BY
WM. GRUNERWALD & ASSOC. c-N $\frac{1}{2}$, N $\frac{1}{2}$, NW, Sec 12, T28S, R13W FINCHAM NO. 1 PRATT COUNTY, KANSAS			
NIXON & SEAMAN ENGINEERS BOX 81 LIBERAL, KANSAS		DATE: 9-28-66 DRAWN BY: Nixon DRWG. NO 66130 SHEET NO 1 OF 1	