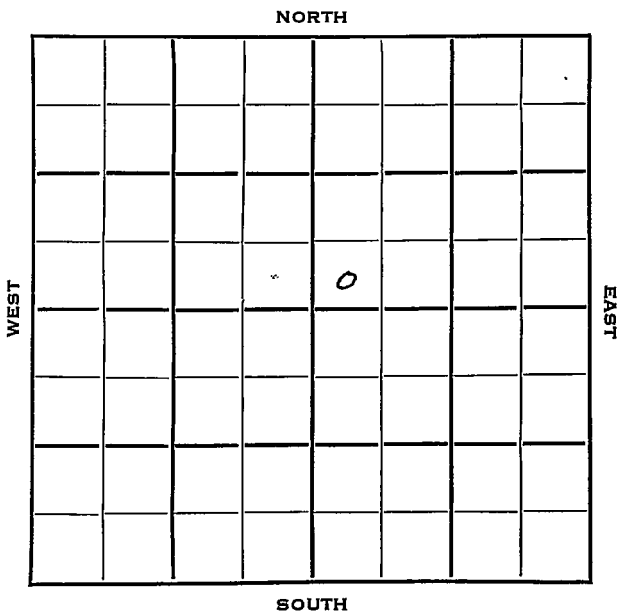


Section 13 Township 28 Range 33WWell No. #1 CallohnCompany Huber Corporation

Haskell

KANSAS

Sec. 13 Twp. 28 R. 33W

Well No. #1 Callohn Farm

Huber Corporation Company

Contractor


Ft. from N. Line

150 Ft. from S. Line

Ft. from E. Line

150 Ft. from W. Line

SW NE

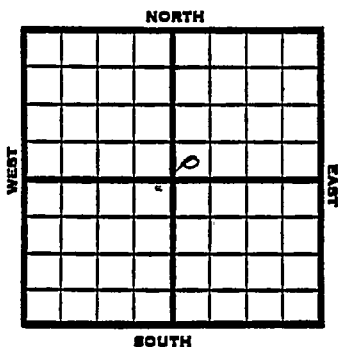

1953 Elev. 2955' REPORT

3/11	Location
------	----------

3/18 8" @604
Her 2638, Up Kr 2663, Low Kr
2685
RTD 2690
5" @ 2686

3/26 DD 2700 5000 A

4/1 Spud 3-11-53 Gas well TD 2740
8" @ 604 Her. 2638 Kri. 2663
TD 2690 5" @ 2686 DD 2700
5000 A DD 2740 3000 A
Comp. 1,916,000 gas.

COMPLETED

County Haskell State Kansas

Sec. **13** (Blk.) **28** (Sur.) **337** Map No.

Operator Huber Corp.

Well No. 7 Farm Callohn

Elev.	Location	SW NE

			0		
FIRST REPORT					

150 Ft. From S Line NE

750 Ft. From W Line Quarter

1st. Report MAR 11 1953

Completion

Remarks

Spudding Date _____

Drlg. Data

Location

J. G. McGEHEE