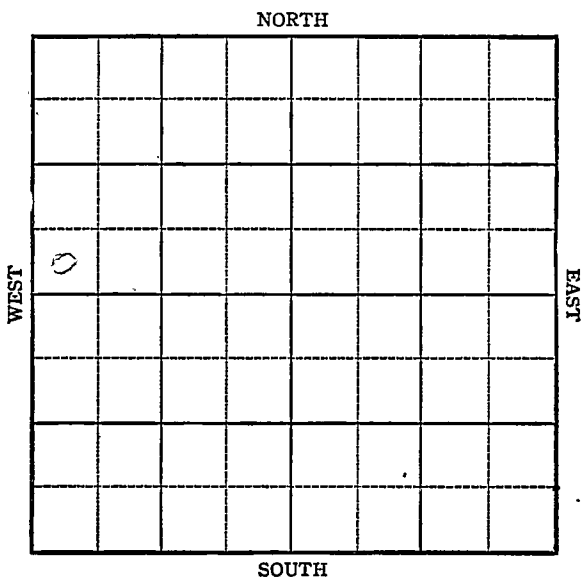


KANSAS

Pratt County

Section 13 Township 28 Range 12WWell No. #1 FeeCompany J. C. Lemon et al

Pratt Co.

Chitwood

KANSAS

Sec. 13 Twp. 28 R. 12W

Well No. 1 Fee Farm

J. C. Lemon et al Company

SW NW

NORTH

 Ft. from N. Line

330 Ft. from S. Line

 Ft. from E. Line

330 Ft. from W. Line

WEST

EAST

SOUTH

See. 1845

1944

R E P O R T

9-13

Rotary

9/21

10" @ 317

Drlg. 1380

9/28

Drlg. 3022

10/4

Lans 3705

Drlg. 3815

10/11

Miss 4169'

Viola 4373'


TD 4402'

ABANDONED

Pool Name Chitwo od**KANSAS**Map No. 54 Sec. 13 Twp. 28 R. 12WWell No. 1 FeeJ. C. Lemon et al. Company**FIRST REPORT**

Contractor

SW NW

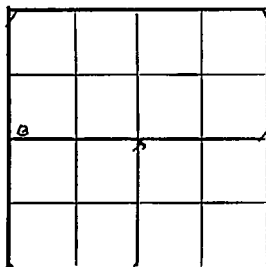SECTION PLAT Ft. from N. Line330 Ft. from S. Line Ft. from E. Line330 Ft. from W. LinePratt CountyLocation Rig up Drilling and Remarks:
Rotary**RECORD**Cased in., ft.Sand Gas Oil Total Depth **PRODUCTION**1st 24 hrs. Nat. 1st 24 hrs. after shot Gas Cu. Ft.Dry Hole Abandoned

Date

SEP 13 194419S. J. LEWIS Scout

Pool Name ChitwoodMap No. 54 Sec. 13 Twp. 28 R. 12WWell No. 1 FeeJ. C. Lemon et al.

Company

ABANDONED

Contractor

SW NW

SECTION FLAT

_____ Ft. from N. Line

330 Ft. from S. Line

_____ Ft. from E. Line

330 Ft. from W. LinePratt County

RECORD

Location _____

Cased _____ in., _____ ft.

Rig up _____

Sand _____

Drilling and Remarks:

Gas _____

Oil _____

Total Depth 4402

PRODUCTION

1st 24 hrs. Nat. _____

1st 24 hrs. after shot _____

Gas _____ Cu. Ft.

Dry Hole _____

Abandoned _____

Date

OCT 11 1944

19

S. J. LEWIS

Scout