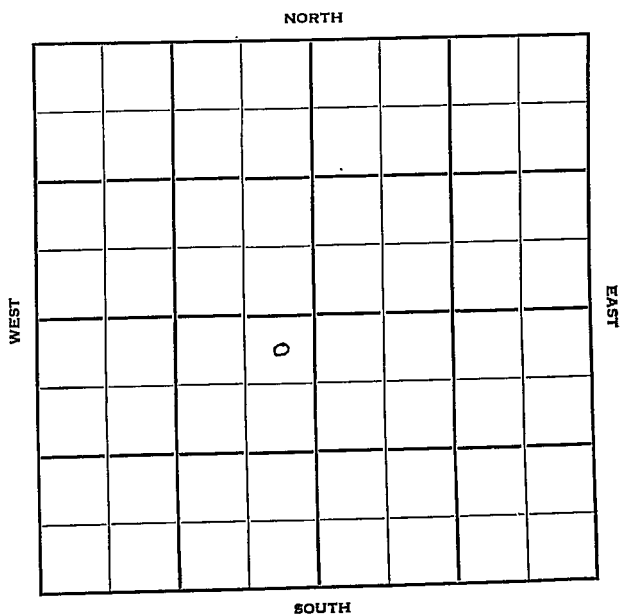


Section 13 Township 28 Range 12-WWell No. #1 Lemon "D"Company Cities Service

Pratt

KANSAS

Sec. 13 Twp. 28 R. 12W ☒

Well No. #1 Lemon "D" Farm

Cities Service

Company

Rine Drlg.

Contractor

Chitwood

330'

Ft. from N. Line


Ft. from S. Line

330'

Ft. from E. Line

Ft. from W. Line

NE NE SW

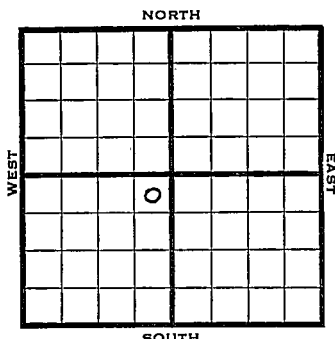

1950	Elev 1855	REPORT
6/28	Location	
9/27	8" @ 330	
	Lans 3708	
	DST 3791-3808 open $\frac{1}{2}$ hr rec 20' mud	
	DST 3826-41 open 45 min rec 310' sw	
	Miss 4141	Kinderhook 4179
	Viola 4340	
	DST 4342-56 open 1 hr rec 37' socm	
	Simp 4444	
	DST 4455-60 open 45 min rec 4' mud	
	Arb 4531-70	
	5" @ 4410	
	CO to 4387	
	46/4330-46	
	1000 A	
	S/16 bo 25 bw 12 hr	
	2500 A	
	Est lmcfg	
	Comp 23 bopd 10% water	
	TD 4570	
	Completed	
	COMPLETED	

Kansas

Map No. _____ Sec. 13 Twp. 28 R. 12WWell No. 1 Lemon "D"

_____ Cities Service _____ Company

_____ Rine Drl'g. _____ Contractor

NE NE SW

330 Ft. from N. Line

_____ Ft. from S. Line

330 Ft. from E. Line

_____ Ft. from W. Line

SECTION PLAT



Pratt County

Location X

Rig up _____

Drilling and Remarks:

RECORD

Cased _____ in. _____ ft.

Sand _____

Gas _____

Oil _____

Total Depth _____

PRODUCTION

1st 24 hrs. Nat. _____

1st 24 hrs. after shot _____


Gas _____ Cu. Ft.

Dry Hole _____

Abandoned _____

Date

JUN 28 1950 19J. E. TYRA Scout

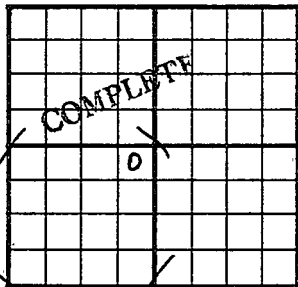County Pratt State KansasSec. 13 (Blk.
Twp.) 28 (Sur.
Rge.) 12W Map No.Operator Cities ServiceWell No. 1 Farm Lemon "D"Elev. 1855 Location NE NE SW330 Ft. From N Line SW330 Ft. From E Line Quarter

1st. Report

Completion SEP 27 1950Remarks Chitwood PoolRine Drlg. - Contr.

Spudding Date

Drlg. Data Oil well TD 45708" @ 330 Lans. 3708 DST 3791-3808open $\frac{1}{2}$ hr. Rec. 20' mud DST 3826-41open 45 min. Rec. 310' sw Miss. 4141Kinderhook 4179 Viola 4340 DST 4342-56open 1 hr. Rec. 37' soem Simp. 4444DST 4455-60 open 45 min. Rec. 4' mudArb. 4531-70 5" @ 4410 CO to 438746/ 4330-46 1000 A S/ 16 bo 25 bw 12hr2500 A Est. 1mcf/gComp. 23 bopd 10% water

J. E. TYRA