SIDE ONE

STATE CORPORATION COMMISSION OF KANSAS
OIL & GAS CONSERVATION DIVISION
WELL COMPLETION OR RECOMPLETION FORM
ACO-1 WELL HISTORY
DESCRIPTION OF WELL AND LEASE

API NO. 15- 151-20,181-A

County: Pratt

C SW SW SE Sec. 25 Twp. 28S Rge. 14 ___ East X West

330 Ft North from Southeast Corner of Section
2310 Ft West from Southeast Corner of Section
(Note: Locate well in section plat below)

Lease Name: Hertlein Well #: 1

Field Name: Earl

Producing Formation: Viola

Elevation: Ground: 1981 KB: 1986

Operator: License # 3536
Name: RAMCO Drilling Service, Inc.
Address: P.O. Box 99
City/State/Zip: Belpre, OH 45714

Purchaser: Texaco

Operator Contact Person: David Gocke
Phone: (614) 423-9591

Contractor: License # 5422
Name: Abercrombie Drilling, Inc.

Wellsite Geologist:
Phone:

Designate Type of Completion
___ New Well X Re-Entry ___ Workover

___ Oil ___ SWD ___ Temp Abd
___ Gas ___ Inj ___ Delayed Comp.
___ Dry ___ Other (Core, Water Supply etc.)

If OWWO: old well info as follows:
Operator: Edmiston Oil Company
Well Name: Hertlein #1
Comp. Date: 9/30/71 Old Total Depth: 4544'

RECEIVED
STATE CORPORATION COMMISSION
OCT 7 1988
CONSERVATION DIVISION
Wichita, Kansas

Section Plat

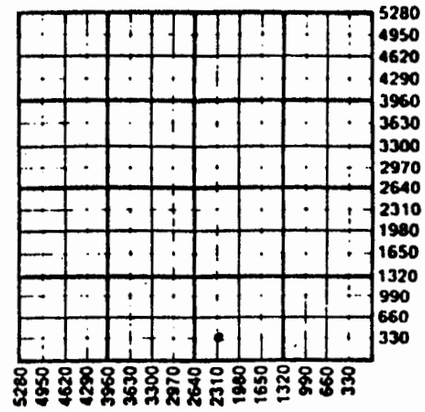

WELL HISTORY

Drilling Method:
X Mud Rotary ___ Air Rotary ___ Cable

8/02/88	8/03/88	08/08/88
Spud Date	Date Reached TD	Completion Date

4544'	4515'
Total Depth	PBTD

Amount of Surface Pipe Set and Cemented at 406 feet
Multiple Stage Cementing Collar Used? ___ Yes ___ No
If yes, show depth set: ___ feet
If alternate 2 completion, cement circulated from ___ feet depth to ___ w/ ___ SX cmt
Cement Company Name:
Invoice #:

WATER SUPPLY INFORMATION
Disposition of Produced Water: ___ Disposal
Docket #: ___ Repressuring

Questions on this portion of the ACO-1 call:
Water Resources Board (913) 296-3717
Source of Water:
Division of Water Resources Permit #: T 88-429

X Groundwater 440 Ft North from Southeast Corner
(Well) 2300 Ft West from Southeast Corner of
Sec 25 Twp 28S Rge 14 ___ East X West

___ Surface Water ___ Ft North from Southeast Corner
(Stream, pond etc) ___ Ft West from Southeast Corner
Sec Twp Rge ___ East ___ West

___ Other (explain)
(purchased from city, R.W.D. #)

INSTRUCTIONS: This form shall be completed in triplicate and filed with the Kansas Corporation Commission, 200 Colorado Derby Building, Wichita, Kansas 67202, within 120 days of the spud date of any well. Rule 82-3-130, 82-3-107 and 82-3-106 apply.
Information on side two of this form will be held confidential for a period of 12 months if requested in writing and submitted with the form. See rule 82-3-107 for confidentiality in excess of 12 months.
One copy of all wireline logs and drillers time log shall be attached with this form. Submit CP-4 form with all plugged wells. Submit CP-111 form with all temporarily abandoned wells.

All requirements of the statutes, rules and regulations promulgated to regulate the oil and gas industry have been fully complied with and the statements herein are complete and correct to the best of my knowledge.

Signature: [signature]
Title: V.P. / Engr. Date: 9-21-88

Subscribed and sworn to before me this 21st day of September 19 88
Notary Public: James E. Blair
Date Commission Expires: James E. Blair, Notary Public, State of West Virginia, My Commission Expires April 7, 1994

K.C.C. OFFICE USE ONLY
F ___ Letter of Confidentiality Attached
C ___ Wireline Log Received
C ___ Drillers Timelog Received
Distribution
___ KCC ___ SWD/Rep ___ NGPA
X KGS ___ Plug ___ Other (Specify)

Sec 25 Twp 28 Rge 14 W

Form ACO-1 (5-86)

OCT 19 1988

KANSAS GEOLOGICAL SURVEY
WICHITA BRANCH