FORM 51 25M 3-49 PETROL

KANSAS


Grant

Section 14 Township 28 Range 37W

Well No. 1 C. Patterson

Company Magnolia

Hugoton

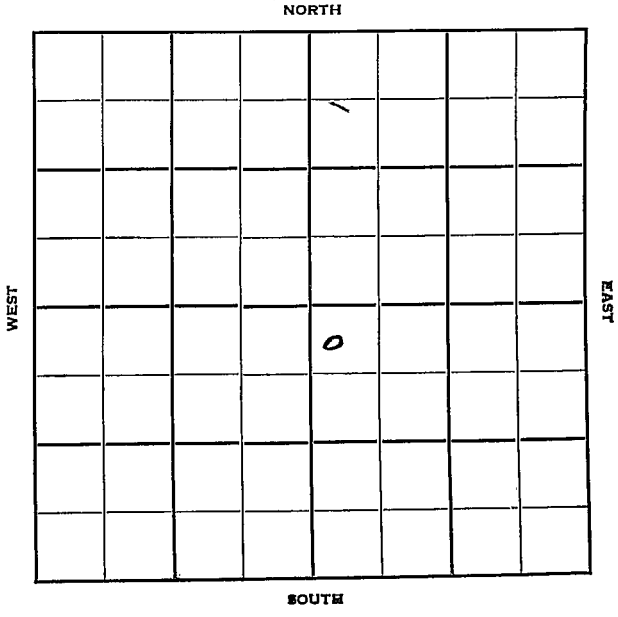

FORM 252-A
5M 10-48 PETROL

Grant KANSAS

Sec. 14 Twp. 28 R. 37W

Well No. #1 C. Patterson Farm

Magnolia Company

Hugoton Pool (Keyes Drlg., Cont.)


330' Ft. from N. Line

Ft. from S. Line

Ft. from E. Line

330' Ft. from W. Line

NW SE

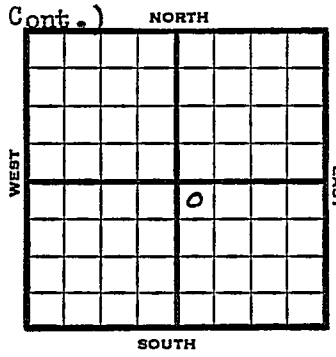

1949	Elev 3018' REPORT
6/29	10" @ 650'
	Drlg. 2405'
7/6	TD 2630'
	7"@ 2629'
7/12	336 shots 2486 - 2578 - 14,000 acid
7/20	"
7/27	24 shots 2348'-53
	7000 acid
8/3	"
8/10	TD 2630'
	7"@ 2629'
	Perf
	37000 acid
	17,400,000 Gas
	390# R Pr;
	Comp
	COMPLETED

Form 26 200 Bks. 9-48 Petrol

Kansas

Hugoton Pool

Map No. _____ Sec. 14 Twp. 28 R. 37W

Well No. 1 C. Patterson


Magnolia Company

Keyes Drlg. Contractor

NW SE

FIRST REPORT

SECTION PLAT

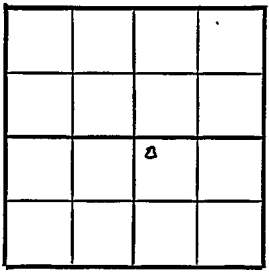

330 Ft. from N. Line

_____ Ft. from S. Line

_____ Ft. from E. Line

330 Ft. from W. Line

Grant County

Location _____

Rig up _____

Drilling and Remarks:

10" @ 650

drlg. 2405

RECORD

Cased _____ in., _____ ft.

Sand _____

Gas _____

Oil _____

Total Depth _____

PRODUCTION

1st 24 hrs. Nat. _____

1st 24 hrs. after shot _____

Gas _____ Cu. Ft.

Dry Hole _____

Abandoned _____

Date

JUN 29 1949 19

S. J. LEWIS Scout

Form 26 200 Bks. 6-49 Petrol

Hugoton Pool

Kansas

Map No. _____ Sec. 14 Twp. 28 R. 37W

Well No. 1 C. Patterson

Magnolia Company


COMPLETE

Contractor

NW SE

El. 3018

SECTION PLAT

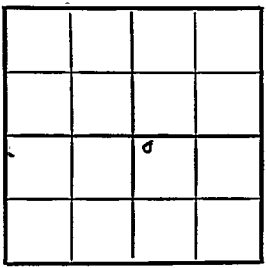

330 Ft. from N. Line

Ft. from S. Line

Ft. from E. Line

330 Ft. from W. Line

Grant County

Location

Rig up

Drilling and Remarks:

7" @2629

Perf.

67000 acid

17,400,000 Gas

390 ★ RA

RECORD

Cased in., ft.

Sand

Gas

Oil

Total Depth 2630

PRODUCTION

1st 24 hrs. Nat.

1st 24 hrs. after shot

Gas Cu. Ft.

Dry Hole

Abandoned

Date

AUG 10 1949 19

S. J. LEWIS Scout