


KANSAS

Section 14 Township 28 Range 33-W

Well No. #1 E. Cox

Company National Assoc. Pet.

NORTH

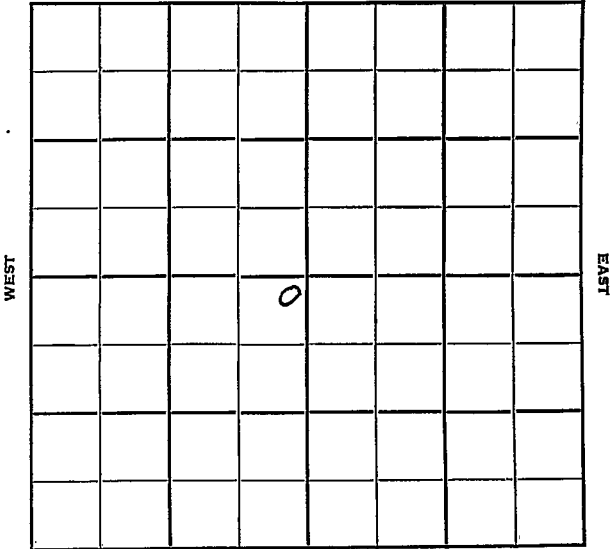

SOUTH

Haske11

KANSAS

Sec. 14 Twp. 28 R. 33W

Well No. #1 E. Cox Farm

National Assoc. Pet. Company

Hugoton Pool Contractor


100' Ft. from N. Line

Ft. from S. Line

100' Ft. from E. Line

Ft. from W. Line

NE SW

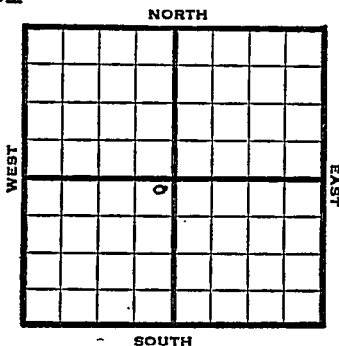

1950 Elev. 2967' REPORT


11/15 Spud 11-4-50
10" @ 605'
Drlg. 1350'

1951
3/7 Spud 11-4-50
Gas well TD 2765
10" @ 605 6" @ 2710
TD 2765 SP 2718 23 1/4 / 2674-2713
252 / 2662-2704
Her. 2661 Krider 2680 Win. 2721
26,500 A
Comp. 11,630,000 gas 387#

COMPLETED

J. E. TYRA

County Haskell State Kansas
 Sec. 14 (Blk.) 28 (Sur.) 33W Map No.
 Operator National Assoc. Pet.
 Well No. 1 Farm E. Cox
 Elev. 2967 Location NE SW

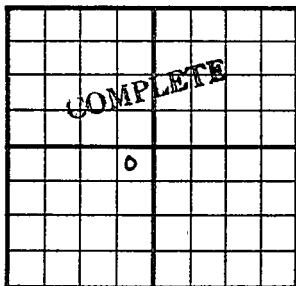

100 Ft. From N Line SW
100 Ft. From E Line Quarter
 1st. Report
 Completion MAR 7 1951
 Remarks Hugoton Pool

Spudding Date 11-4-50

Drlg. Data Gas well TD 2765
10" @ 605 6" @ 2710 TD 2765 SP 2718
234/ 2674-2713 252/ 2662-2704
Her. 2661 Krider 2680 Win. 2721
26500 A Comp. 11,630,000 gas 387#

J. E. TYRA