


Kiowa

KANSAS

SECTION 14 TOWNSHIP 28S RANGE 19W

WELL NO. #1 Rice Unit

COMPANY E. K. Carey

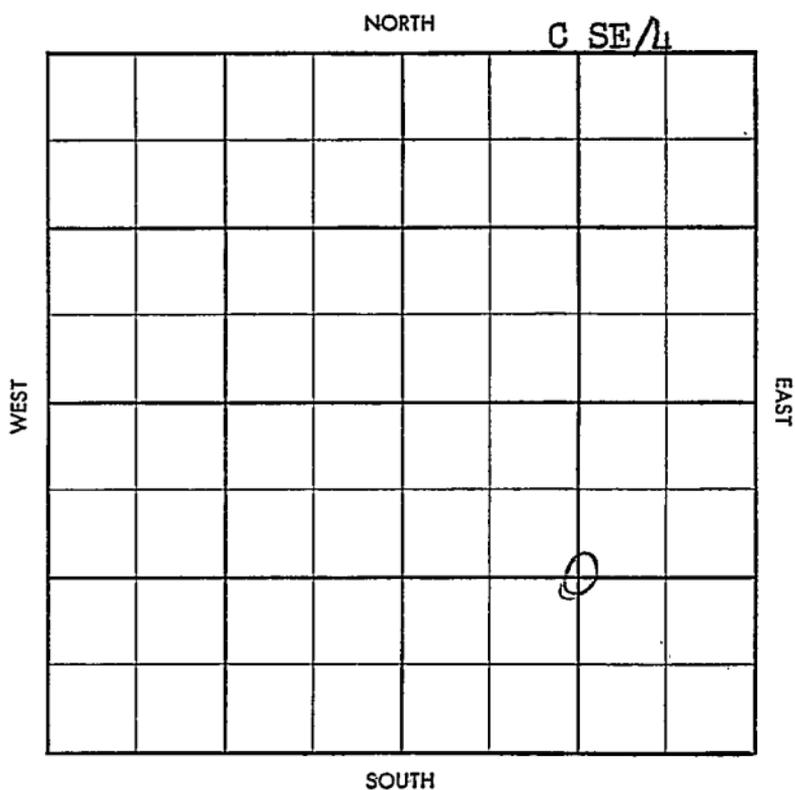

Twp. ~~X~~ Pool ~~X~~
 Co. ~~X~~ Facet ~~X~~

S-513-B

County Kiowa Elev. _____
 Sec. 14 Twp. 28 Rge. 19W
 Company E. K. Carey
 Farm Name Rice Unit No. 1

TOPS	DEPTH	LOG	DATUM
Anh.			
Tp.			
H.			
Tr.			
Dg.			
B.L.			
L.			
K.C.			
B.K.C.			
Ce.			
C.			
M.			
M.			
K.			
Mz.			
Mq.			
V.			
S.			
S.			
A.			
R.			
Pf.			
G.			
T.D.			

Loc. in Sec. _____
C SE/4
 Geol. _____
 Contr. _____
Capitt Drlg.
 Pool _____
Johansen

FIRST REPORT
 MAY 28 '58

Date Comm. 5/26/58
8" @ 298 w/250, WOC

Co.
Lse.
No.
Sec.
T.
R.

Co. ~~X~~ Facet ~~X~~

5-513-B

County Kiowa Elev. 22580f. 226188
 Sec. 14 Twp. 28 Rge. 194
 Company E. K. Carey
 Farm Name Rice Unit No. 1

TOPS	DEPTH	LOG	DATUM
Anh.			
Tr.			
H.	<u>4087</u>		
Tr.			
Dg.	<u>4162</u>		
B.L.	<u>4296</u>		
L.	<u>KC 4254</u>		
K.C.			
B.K.C.			
Ce.			
C.			
M.	<u>X 4863</u>		
M.	<u>DST</u>		
K.			
Mz.			
Mq.			
V.			
S.			
S.			
A.			
R.			
Pf.			
G.			
T.D.	<u>4923</u>		

Loc. in Sec. G 9F/4
 Geol. _____
 Contr. Capitt Prtg.
 Pool Johansen

ABANDONED
 JUN 18 '58

Date Comm. 5/26/58
8 1/2" @ 209 w/250, 00 JUN 3 '58 @ 3520
JUN 11 '58 Tops @ 4676 JUN 12 '58 Top
DST 4865-70 24. 30'M
FP 230-290 BHP 590/30" -
1450/30" DST 4868-78 2hrs
30'M FP 25-25 BHP 1695/30"
- 185/30 TD 4923 no log

D6A

Co.
 No.
 Sec.
 T.
 R.