

KANSAS

FORM 51 10M 12-46 PETROL


Stanton

Section 14 Township 28 Range 39-W

Well No. 1 Hinshaw "A"

Company Stanolind

Hugoton Pool

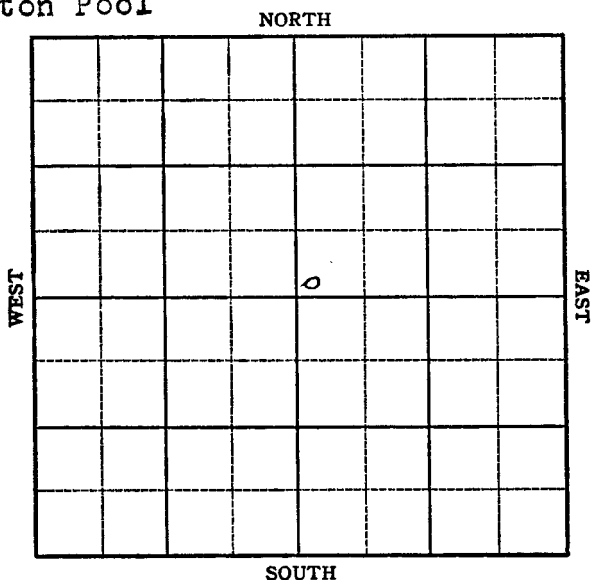

KANSAS

Stanton



Sec. 14 Twp. 28 R. 39W

Well No. #1 Hinshaw "A" Farm

Stanolind Company

Hugoton


Ft. from N. Line

150 Ft. from S. Line

Ft. from E. Line

150 Ft. from W. Line

SW NE

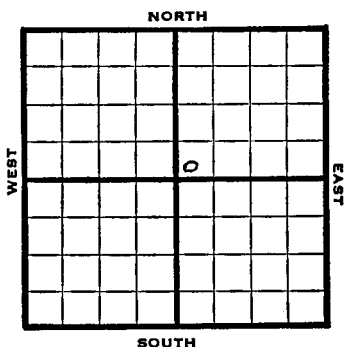

1947 Elev. 3143' REPORT

Date	Location
9/17	Location
9/24	10" @ 660'
	TD 2815'
	7" @ 2315'
	RUST
10/1	"
10/8	"
10/15	"
10/22	"
10/29	"
11/5	"
11/12	"
11/19	"
11/25	"
12/3	"
12/10	"
12/17	"
12/30	"
1948	
1/7	"
1/14	"
1/21	"

OVER

1948

1/26

10"@ 660'
TD 2815'
7"@ 2315'
RUST

2/4

"

2/11

"

2/18

TD 2494'
228' of 5" Perfliner @ 2494'
17000 acid

2/25

7" @ 2284'
228' of 5" perf. liner @ 2494'
17000 acid
8,175,000 gas.
430# R. Pr.
TD 2494'
Comp.

COMPLETED

Map No. _____ Sec. 14 Twp. 28 R. 39W

Well No. 1 Hinshaw "A"

Stanolind


Company

COMPLETE

Contractor

SW NE

E1, 3/4
SECTION PLAT

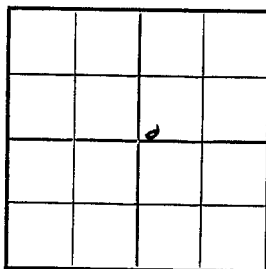

_____ Ft. from N. Line

150

_____ Ft. from S. Line

_____ Ft. from E. Line

150

_____ Ft. from W. Line

Stanton County

Location _____

Rig up _____

Drilling and Remarks:

7" @ 2254

225' of 5" Pipe Line

@ 2494

17000 cu ft

8, 175, 000 Gas

430 "R" #

RECORD

Cased _____ in., _____ ft.

Sand _____

Gas _____

Oil _____

Total Depth 2494

PRODUCTION

1st 24 hrs. Nat. _____

1st 24 hrs. after shot _____

Gas _____ Cu. Ft.

Dry Hole _____

Abandoned _____

Date

FEB 25 1946

19

S. J. LEWIS

Scout

Map No. _____ Sec. 14 Twp. 28 R. 39W

Well No. 1 Winshaw "A"

Stanolind


Company

FIRST REPORT

Contractor

SEE PAGE

SECTION PLAT

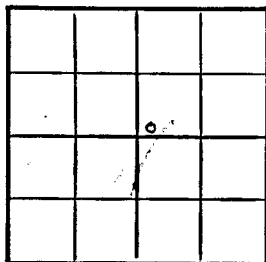

_____ Ft. from N. Line

150 Ft. from S. Line

_____ Ft. from E. Line

150 Ft. from W. Line

Stanton County

Location X

Rig up _____

Drilling and Remarks:

RECORD

Cased _____ in, _____ ft.

Sand _____

Gas _____

Oil _____

Total Depth _____

PRODUCTION

1st 24 hrs. Nat. _____

1st 24 hrs. after shot _____

Gas _____ Cu. Ft.

Dry Hole _____

Abandoned _____

Date

SEP 1 1947 19 S. J. LEWIS Scout