


Section 14 Township 28 Range 40-W

Well No. #1 Beekett

Company W E Bakke
Hugoton Pool

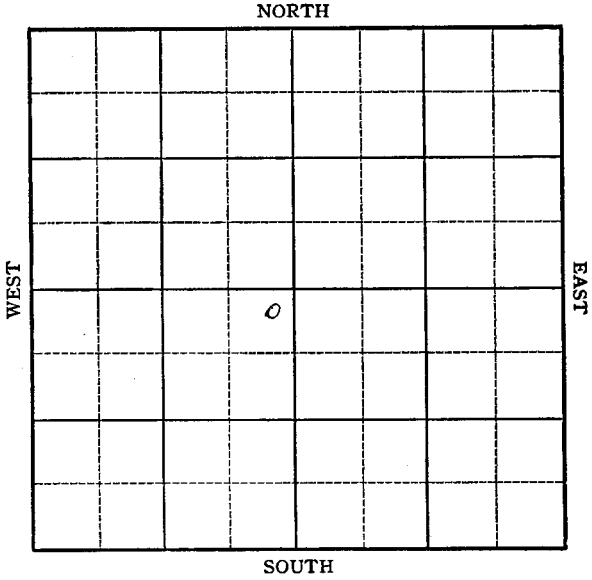

Stanton

Sec. 14 Twp. 28 R. 40W

Well No. #1 Beckett Farm

W. E. Bakke Company

Contractor

Hugoton Pool


200' Ft. from N. Line

Ft. from S. Line

200' Ft. from E. Line

Ft. from W. Line

NE SW

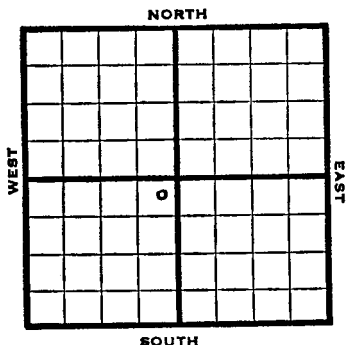

1949 Elev 3246' REPORT

11/9	Location
11/16	10" @ 606'
	Drlg 800'
11/23	TD 2250'
	7" @ 2240'
11/29	TD 2460'
	242' of 5" Perf Liner @ 2460'
12/7	"
12/14	"
12/21	"
12/28	"
1950	
1/11	TD 2460'
	10" @ 606'
	7" @ 2240'
	22000 acid
	6,250,000 gas opn flow
	Herr 2245'
	Krider 2270'
	Win 2315'
	Ft Riley 2415'
	Comp

COMPLETED

Map No. _____ Sec. 14 Twp. 28 R. 40W

Well No. 1 Beekett

W. E. Bakke Company

NE SW Contractor

FIRST REPORT
SECTION PLAT

	o		

200 Ft. from N. Line

_____ Ft. from S. Line

200 Ft. from E. Line

_____ Ft. from W. Line

Stanton County

Location X

Rig up

Drilling and Remarks:

RECORD

Cased _____ in., _____ ft.

Sand _____

Gas _____

Oil _____

Total Depth _____

PRODUCTION

1st 24 hrs. Nat. _____

1st 24 hrs. after shot _____

Gas _____ Cu. Ft.

Dry Hole _____

Abandoned _____

Date

NOV 3 1949 19 S. J. LEWIS Scout

Map No. _____ Sec. 14 Twp. 28 R. 40WWell No. 1 BeckettW. E. Bakke


Company

Contractor

NE SW

E. 3246

SECTION PLAT

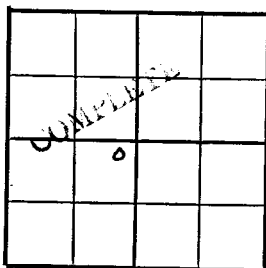200 Ft. from N. Line

_____ Ft. from S. Line

200 Ft. from E. Line

_____ Ft. from W. Line

Stanton County

Location _____

Rig up _____

Drilling and Remarks:

10" @ 6067" @ 224022,000 acid6, 250, 000 gas
open flow1 derr. 2245Krider 2270Win. 2315Foreman 2362F. T. Riley 2415

Date

RECORD

Cased _____ in., _____ ft.

Sand _____

Gas _____

Oil _____

Total Depth 2460

PRODUCTION

1st 24 hrs. Nat. _____

1st 24 hrs. after shot _____

Gas _____ Cu. Ft.

Dry Hole _____

Abandoned _____

JAN 11 1950

19

J. E. TYRA Scout