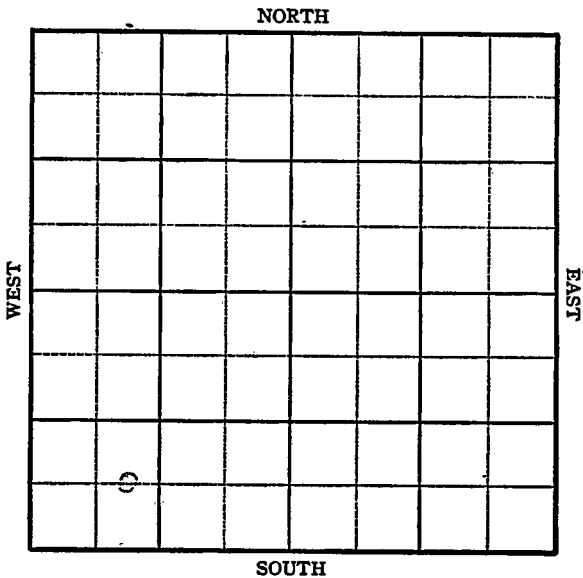


KANSAS

Pratt

FORM 51 5M PETROL

Section 14 Township 28 Range 12WWell No. 2 HillardCompany Skelly

Sec. 14 Twp. 28 R. 12-W

Well No. #2 Hillard Farm


Skelly Company

 Ft. from N. Line

660 Ft. from S. Line

 Ft. from E. Line

990 Ft. from W. Line

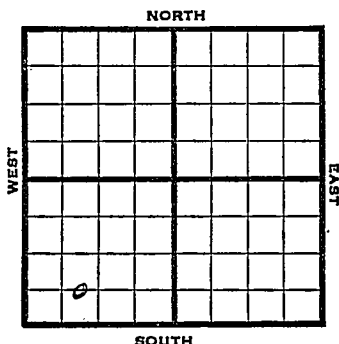

C E L SW SW :

1945 Elev. 1860' REPORT

10/24	Location		
10/31	RUR		
11/7	8" @ 338 WOC		
11/14	Drlg. 2455'		
11/21	Drlg. 3385		
11/28	Lans. 3711		
	Drlg. 4125		
12/5	Viola 4294		
	Simp 4390		
	Sd. 4406-4409		
	TD 4409 fsg.		
12/12	"	"	"
12/20	"	"	"
12/29	Whipstock 3600'		
	Drlg. 3630'		
1946			
1/10	Viola 4314'	Simp Sand 4448'	
	T.D. 4431'	Run Casing.	
1/17	"	"	"
1/24	P.B. 3585'	Drlg. 3614'	
1/31	Drlg. 4215'		
2/7	Viola 4296'	Simp Sand 4404-4419'	T.D.
	5" - 4404'	RUST.	
2/14	"	"	"
2/21	"	"	"
2/28	"	"	"
3/7	T.D. 4419' Plug 4330'		
	72 shots 4296-4308' 500 acid.		
	Swab 90 oil & 24 water in 24 hours.		

OVER

1946

3/13 Viola 4296
Simp sd. 4404
5" @ 4404
Perf. Viola
500 acid.
TD 4419'
Pump 113 oil plus 13% W. Pot.
Grav. 40.9

COMPLETED

Kansas Pool Name ChitwoodMap No. 54S Sec. 14 Twp. 28 R. 12WWell No. 2 Hillard

Skelly _____ Company

FIRST REPORT _____ Contractor

C E L SW SW

SECTION PLAT

_____ Ft. from N. Line

660 Ft. from S. Line

_____ Ft. from E. Line

990 Ft. from W. Line

Pratt County

Location X

Rig up _____

Drilling and Remarks:

RECORD

Cased _____ in., _____ ft.

Sand _____

Gas _____

Oil _____

Total Depth _____

PRODUCTION

1st 24 hrs. Nat. _____

1st 24 hrs. after shot _____

Gas _____ Cu. Ft.

Dry Hole _____

Abandoned _____

Date

OCT 24 1945

19

S. J. LEWIS Scout

Misc. Small Maps

Cards

Tracing

France Map

Scarborough Map

Pierce Map

Geological Dept.

Pierce Plat Book

KANSAS

Kansas

Pool Name ChitwoodMap No. 54 Sec. 14 Twp. 28 R. 12WWell No. 2 Hillard

Skelly

Company

COMPLETED

Contractor

C E L SW SW

21, 1868
SECTION PLAT

0			

Ft. from N. Line

660 Ft. from S. Line

Ft. from E. Line

990 Ft. from W. LinePratt County

Location

Rig up

Drilling and Remarks:

Viola 4296Sum. Sol 44045K 4404Perf Viola500 acidPump 113 oil +18 to 4 R

RECORD

Cased _____ in., _____ ft.

Sand _____

Gas _____

Oil _____

Total Depth 4419

PRODUCTION

1st 24 hrs. Nat. _____

1st 24 hrs. after shot _____

Gas _____ Cu. Ft.

Dry Hole _____

Abandoned _____

Date

40 3/4


MAR 13 1946

19

S. J. LEWIS

Scout

43

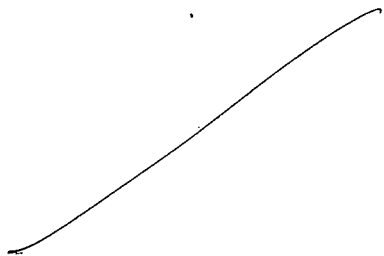

Misc. Small Maps	<i>CH</i>
Cards	<i>Barry</i>
Tracing	<i>J</i>
France Map	<i>[Signature]</i>
Scarborough Map	<i>[Signature]</i>
Pierce Map	<i>[Signature]</i>
Geological Dept.	_____
Pierce Plat Book	_____