


Section 15 Township 28 Range 5 WWell No. # 2 Lansdown & FoleyCompany Hamrick & Smith

NORTH

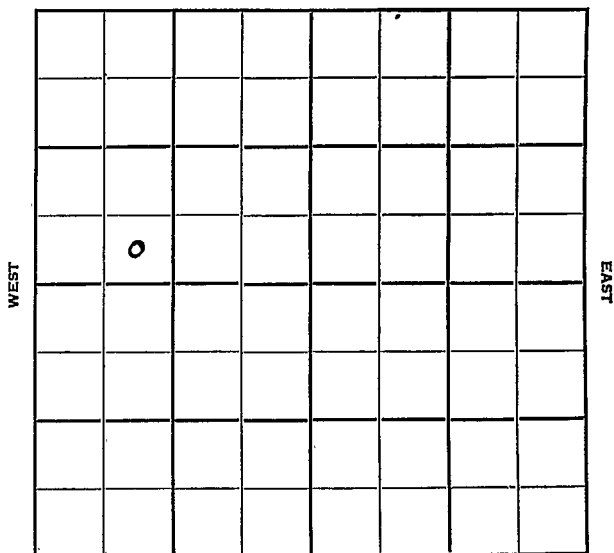

SOUTH

Kingman

KANSAS ✓

Sec. 15 Twp. 28 R. 5W

Well No. #2 Landsdown & Foley Farm

Hamrick & Smith Company

Pabco - Contr. Contractor


 Ft. from N. Line

350' Ft. from S. Line

 Ft. from E. Line

990' Ft. from W. Line

SE SW NW

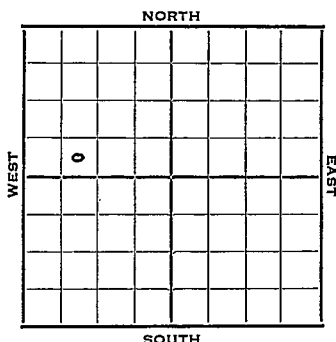

1952 Elev. 1401' REPORT

3/12	Spud 2-29-52 8" @ 163 Drlg. 3670'
3/19	Miss 3796' RTD 3828' 5" @ 3821' CO to 3828'
3/25	DD to 3837' TD S/ wtr. PB 3828' 1000 A Testing
4/1	2000 A POP
4/9	POP
4/23	"
4/30	NR
5/7	"
5/14	"
5/21	"
5/28	"
6/11	"
6/18	"
6/25	"
7/2	"
7/9	"
7/17	Strate lift. Fill up 3000' fluid
7/23	NR

ERROR

OVER

1952

7/30	NR		
8/6	P/3	BOPD	
8/13	NR		
8/20	"		
8/27	"		
9/3	"		
9/10	"		
9/17	"		
9/24	"		
10/1	"		
10/8	"		
10/15	P 3	BOPD WOP	
10/22	No report		
10/29	"		
11/5	"		
11/12	"		
11/20	"		
11/27	"		
12/4	"		
12/11	NR		
12/17	Spud 2-29-52		
	D&A		
	TD 3837		
	8" @ 163		
	Miss 3796		
	TD 3828		
	5" @ 3821		
	CO to 3828		
	DD 3837	S/wtr	PB 3828
	1000A	2000A	P/3 bopd
	D&A		

ABANDONED

County Kingman State Kansas
 Sec. 15 (Blk. 28 (Sur. 5W Map No.

Operator Hamrick & Smith

Well No. 2 Farm Lansdown & Foley

Elev. Location SE SW NW

FIRST REPORT

350 Ft. From S Line NW

990 Ft. From N Line Quarter

1st. Report MAR 1 2 1952

Completion

Remarks

Pabco - Contr.

Spudding Date 2-29-52

Drig. Data

8" @ 163 Drig. 3670

J. G. McGEHEE

MAR 14 1982

Scout Cards	<i>DR</i>
Land Small Map	
Land Wall Map	<i>DR</i>
Tracings	
France Map	
Pierce Map	
Misc.	

Orig. Data

J. G. McGEHEE

Scout Cards

Land Small Map

Land Wall Map

Tracings

France Map

Pierce Map

Misc.

DEC 30 1952

Drig. Data