

FORM 51


Kingman

KANSAS

Section 15 Township 28 Range 5W

Well No. #1 Lindholm "C"

Company Beardmore Drlg. Company

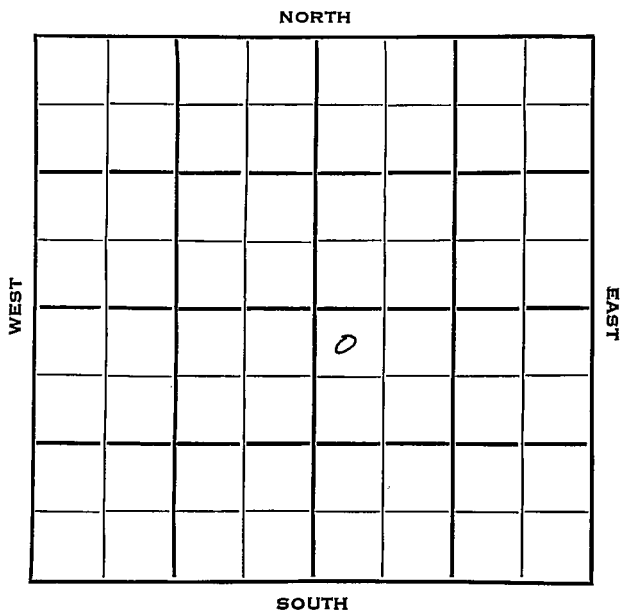


Kingman

KANSAS

Sec. 15 Twp. 28 R. 5 WWell No. # 1 Lindholm "C" FarmBeardmore Drlg. CompanyBroadway Pool Contractor330 Ft. from N. Line Ft. from S. Line Ft. from E. Line330 Ft. from W. Line

NW NW SE

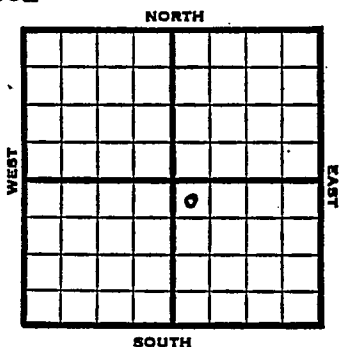

1953

Elev. 1392'

REPORT

3/25

4/2

4/9

4/16

4/23

4/29

Spud 3-24-53

8" @ 126'

Drlg 3305'

Lans 2993, Miss 3787

DST 3788-3815, 1 hr., 50,000 gas

160' GCM, 1260#

DST 3812-35, 1 $\frac{1}{4}$ hrs., 90' GCM, 60' OCM, 850#

DST 4191-4203, 1/2 hrs., 10' m, 1460#

Drlg. 4230 for SWD

NR

Arb 4323

RTD 4540

5" @ 4340'

Spud 3-24-53 SWD well TD 4540

8" @ 126 Lans 2993 Miss 3787

DST 3788-3815 open 1 hr ~~xx~~ 50,000 gas 160' GCM 1260#DST 3812-35 open 1 $\frac{1}{4}$ hr rec 90' GCM 60' OCM 850#DST 4191-4203 open $\frac{1}{2}$ hr rec 10' mud 1460# Arb. 4323 TD 4540

5" @ 4340 CO to 4540 1000 A

Comp. for SWD well

ABANDONED

County Kingman State Kansas
 Sec. 15 (Blk. Twp.) 28 (Sur. Rge.) 5W Map No. _____
 Operator Beardmore Drig.
 Well No. 1 Farm Lindholm "C"
 Elev. _____ Location NW NW SE

330 Ft. From N Line SE

330 Ft. From W Line Quarter

1st. Report MAR 25 1953


Completion _____

Remarks _____

Spudding Date 3-24-53

Drig. Data _____

Broadway Pool

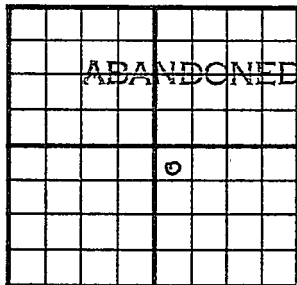County Kingman State KansasSec. 15 (Blk.
Twp.) 28 (Sur.
Rge.) 5W Map No.Operator Beardmore Drlg.Well No. 1 Farm Lindholm "C"Elev. 1392 Location NW NW SE330 Ft. From N Line SE330 Ft. From W Line Quarter1st. ReportCompletion APR 29 1953Remarks Broadway PoolSpudding Date 3-24-53Drlg. Data SWD well TD 45408" @ 126 Lans. 2993 Miss. 3787DST 3788-3815 open 1 hr. 50,000 gas160' gcm 1260# DST 3812-35 open 1 1/4 hr.Rec. 90' gcm 60' ocm 850# DST 4191-4203 open 1/2 hr. Rec. 10' mud 1460#Arb. 4323 TD 4540 5" @ 4340CO to 4540 1000 A Comp. for SWD well