

Section 15 Township 28 Range 5 WWell No. # 1 FoleyCompany O. A. Sutton Corp. et al

NORTH

WEST								
	0							
EAST								

SOUTH

Kingman

KANSAS

Sec. 15 Twp. 28 R. ✓ 5W

Well No. #1 Foley Farm

O. A. Sutton Corp. et al Company

Beardmore Drlg. - Contr. Contractor

Broadway Pool


950' Ft. from N. Line

_____ Ft. from S. Line

_____ Ft. from E. Line

330' Ft. from W. Line

SW NW SW

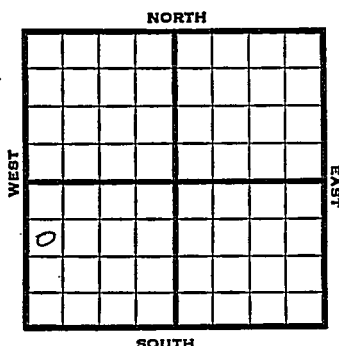

1951 Elev. 1402' REPORT

7/11 RUR

8/22 Spud 7-12-51
Oil Well TD 3835
8" @ 140
Miss lime 3802
Dol. 3828
DST 3822-35 opn 45 min.
Flowed oil 240' mud 10' wtr
TD 3835 5" @ 3822
S. & F/20 boph 500 A
F/15 boph Comp. F/1821 bopd

COMPLETED

County Kingman State KansasSec. 15 (Blk.) 28 (Sur.) 5W Map No.Operator O. A. Sutton Corp. etal.Well- No. 1 Farm FoleyElev. 1402 Location SW NW SW

PAID REPORT

950 Ft. From N Line SW330 Ft. From W Line Quarter1st. Report JUL 11 1951

Completion

Remarks

Beardmore Drlg. - Contr


Spudding Date

Drlg. Data

Broadway - poolRORJ. E. TYRA

County Kingman State Kansas
 Sec. 15 (Blk.) 28 (Sur.) 5W Map No.
 Operator O. A. Sutton Corp. etal.
 Well No. 1 Farm Foley

Elev. 1402 Location SW NW SW

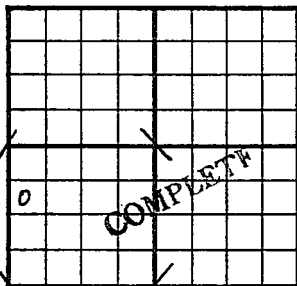

950 Ft. From N Line SW

330 Ft. From W Line Quarter

1st. Report

Completion AUG 22 1951

Remarks Broadway Pool

Beardmore Drlg. - Contr.

Spudding Date 7-12-51

Drlg. Data Oil well TD 3835

8" @ 140 Miss. lime 3802 Dol. 3828

DST 3822-35 open 45 min. Flowed oil

240' mud 10' water TD 3835 5" @ 3822

S & F/ 20 boph 500 A F/ 15 boph

Comp. F/ 1821 bopd