


Section 15 Township 28 Range 5W

Well No. #1 Foley

Company Beardmore

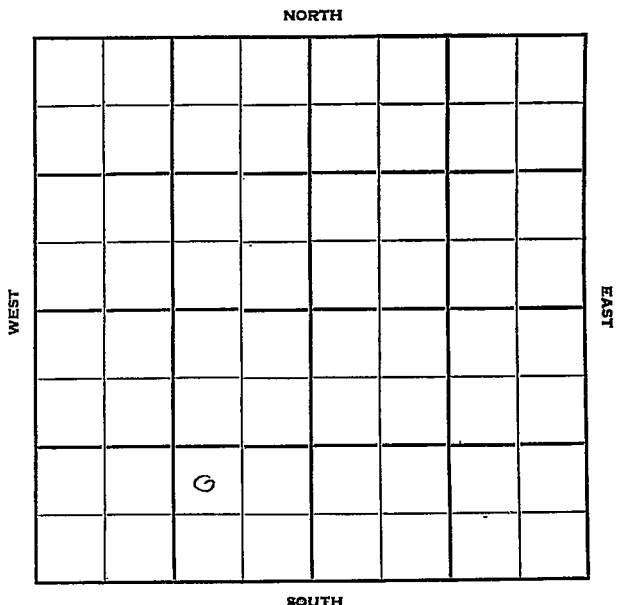

Kingman

Sec. 15 Twp. 28 R. 1 5W

Well No. #4 Foley Farm

Beardmore Company

Beardmore Contractor


Ft. from N. Line

990 Ft. from S. Line

990 Ft. from E. Line

Ft. from W. Line

NW SE SW

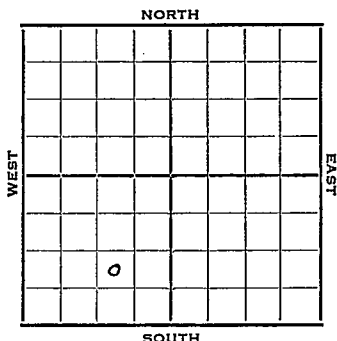

1952


REPORT

4/2 Location
4/9 8" @ 121' WOC
4/23 Spud 4-6-52
D&A TD 3900
8" @ 121 Lans. 3000 Miss. 3796
DST 3810-30 open 1 hr. rec. 180' gcm
DST 3830-43 open 1 hr. rec. 30' mud
TD 3900 D&A

ABANDONED

J. G. McGEHEE

County **Kingman** State **Kansas**
 Sec. **15** (Blk.) **28** (Sur.) **5W** Map No.
 Operator **Beardmore Drlg.**
 Well No. **4** Farm **Foley**
 Elev. **1395** Location **NW SE SW**

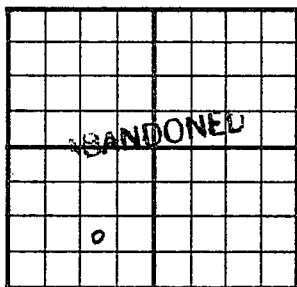

990 Ft. From S Line SW
990 Ft. From E Line Quarter
 Ist. Report
 Completion **APR 23 1952**
 Remarks
Beardmore - Contr.
 Spudding Date **4-6-52**

Drlg. Data **D & A** **TD 3900**
8" @ 121 **Lans. 3000** **Miss. 3796**
DST 3810-30 open 1 hr. Rec. 180' gem
DST 3830-43 open 1 hr. Rec. 30' mud
TD 3900

D & A

J. G. McGEHEE