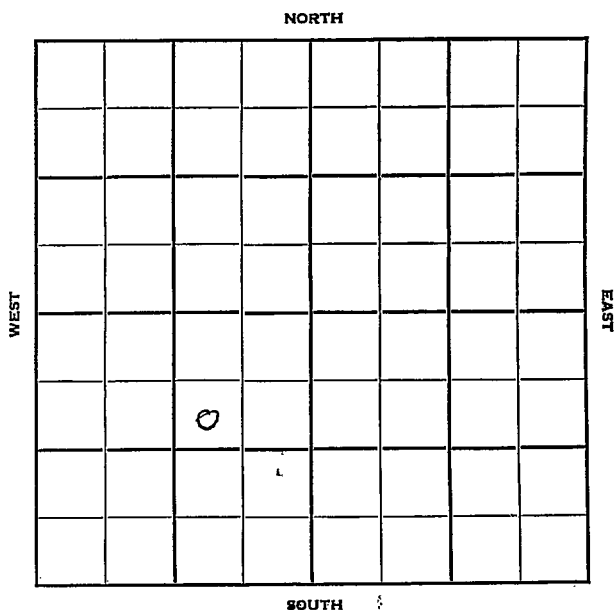


Section 15 Township 28 Range 5WWell No. #3 FoleyCompany Beardmore Drlg.

Kingman

KANSAS

Sec. 15 Twp. 28 R. 5W ✓

Well No. #3 Foley Farm

Beardmore Drlg. Company

Contractor

Broadway


990 Ft. from N. Line

Ft. from S. Line

990 Ft. from E. Line

Ft. from W. Line

SW NE SW

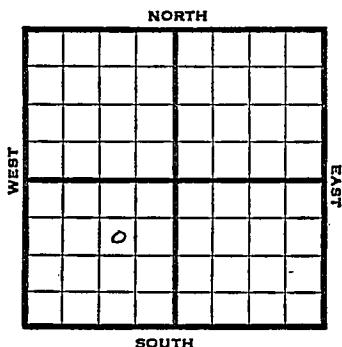

1951

Elev. 1396' REPORT

10/31

Location

12/19

Spud 11-8-51
Oil well TD 2839'
8-5/8" @ 142' Lans. 2999'
Miss. 3800' Dol. 3837'
DST 3813-39 rec 100,000 gas, 150' SO
& GCM, 120' muddy oil, 160' free oil,
20' water.
TD 3839' 5" @ 3813' CO to 3839'
S/3 BOPH 1000 A
F/10 to 12 BOPH 2% water
F/180 BOPD 2% water

COMPLETED

County Kingman State KansasSec. 15 (Blk. 28) (Sur. SW) Map No.Operator Beardmore DrillingWell No. 3 Farm FoleyElev. Location SW NE SW

FIRST REPORT

0

990 Ft. From N Line SW990 Ft. From E Line Quarter1st. Report OCT 31 1951

Completion

Remarks


Spudding Date

Drig. Data Broadway

Location

J. E. TYRA

County Kingman State Kansas
 Sec. 15 (Blk. 28) (Sur. 5W) (Twp. Map No.)
 Operator Beardmore Drlg.
 Well No. 3 Farm Foley
 Elev. 1396 Location SW NE SW

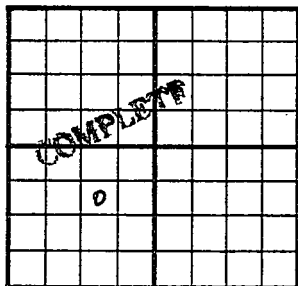

990 Ft. From N Line SW
990 Ft. From E Line Quarter

1st. Report

Completion DEC 1 9 1951

Remarks Broadway Pool

Spudding Date 11-8-51

Drlg. Data Oil well TD 3839

8 5/8" @ 142 Lans. 2999 Miss. 3800

Dol. 3837 DST 3813-39 Rec. 100,000 gas

150' so & gcm 120' muddy oil 160' free

oil 20' water TD 3839 5" @ 3813

CO to 3839 S/ 3 boph 1000 A

F/ 10 to 12 boph 2% water

F/ 180 boph 2% water

J. E. TYRA