


Section 35 Township 28 Range 5W

Well No. #2 Foley

Company Beardmore Drlg.

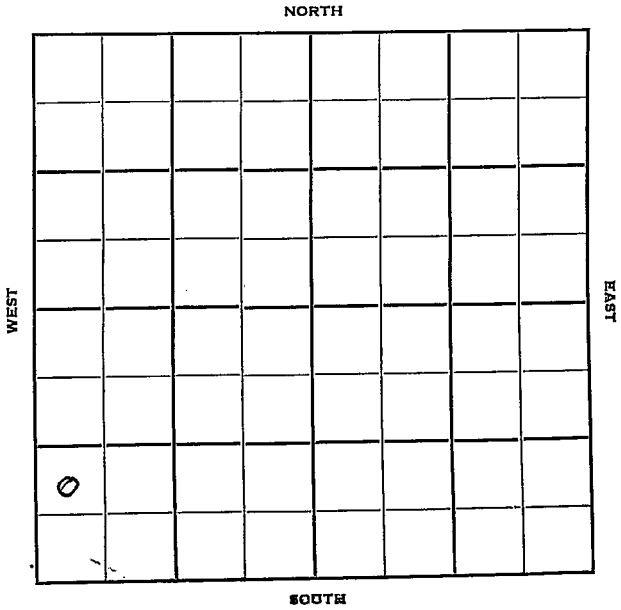

Sec. _____ Twp. _____ R. _____

Well No. # 2 Foley Farm

Beardmore Drlg.

Company

Beardmore Drlg.

Contractor

Broadway Pool


_____ Ft. from N. Line

990 Ft. from S. Line

_____ Ft. from E. Line

330 Ft. from W. Line

NW SW SW

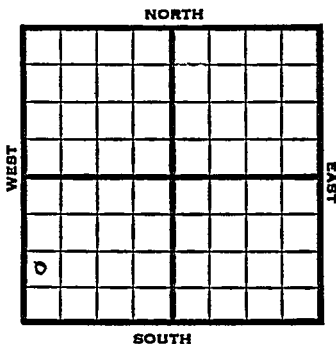

1951

Elev. 1397' REPORT

10/3

RUR

11/28

Spud 10-11-51
 O.1 Well TD 3840
 8" @ 132
 KC 2998' Miss 3794
 Dol. 3829
 DST 3820-40 opn lhr 250,000 gas
 250' hocm 60' mud & oil
 150' oil 30' wtr 5" @ 3825
 TD 3840 S/3 boph
 1000 A F/10 boph 2% wtr
 Comp. 180 bopd 2% wtr.

COMPLETED

County Kingman State Kansas

Sec. 15 (Blk. Twp.) 28 (Sur. Rge.) 5W Map No.

Operator Beardmore Drlg.

Well No. 2 Farm Foley

Elev. _____ Location NW SW SW

FIRST REPORT									

990 Ft. From S Line SW

330 Ft. From W Line Quarter

Ist. Report OCT 3 1951

Completion _____

Remarks _____

Beardmore Drlg. - Contr.

Spudding Date _____

Drlg. Data Broadway Pool

RUR

County Kingman State Kansas

Sec. 15 (Blk. 28) (Sur. 5W) Map No.

Operator Beardmore Drlg.

Well No. 2 Farm Foley

Elev. 1397 Location NW SW SW

990 Ft. From S Line SW

330 Ft. From W Line Quarter

1st. Report

Completion NOV 28 1951

Remarks Broadway Pool

Beardmore Drlg. - Contr.

Spudding Date 10-11-51

Drlg. Data Oil well TD 3840

8" @ 132 KC 2998 Miss. 3794 Dol. 3829

DST 3820-40 open 1 hr. 250,000 gas

250' hoom 60' mud & oil 150' oil

30' water 5" @ 3825 TD 3840 S/ 3 boph

1000 A F/ 10 boph 2% water

Comp. 180 bopd 2% water

J. E. TYRA