

KANSAS

Grant

Form 51-5M-7-40-Palace

Section 15 Township 28 Range 37-W

Well No. #1 Hephthorne

Company Depository Royalty Corp.
~~Clay Bros. et al~~

Wildcat

NORTH

		0					

SOUTH

Sec. 15 Twp. 28 R. 37-W

Well No. #1 Hephthorne Farm

~~Clay Bros. et al~~ **Depository**
Royalty Corp Company


(Wildcat)

_____ Ft. from N. Line

340 Ft. from S. Line

990 Ft. from E. Line

_____ Ft. from W. Line

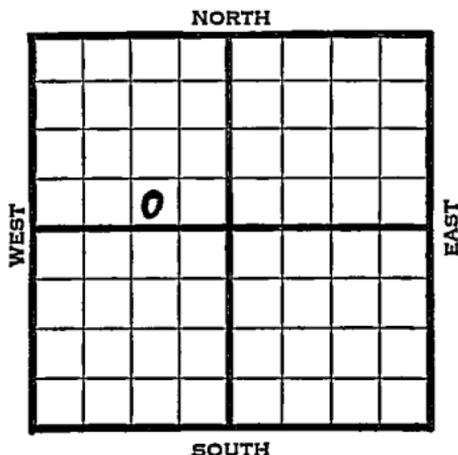

1941	REPORT
3/19	Derrick.
3/27	"
4/3	10" - 543' WOC.
4/10	" " "
4/18	T.D. 2632' Est. 1 3/4
4/24	" " "
	-
4/30	Sand 2376'
	7" - 2376'
	T.D. 2632'
	2000 acid.
	8,520,000 gas.
	COMPLETED

Map No. NM Sec. 15 Twp. 28 R. 37WWell No. 1 HepthorneDepository Royalty Corp. CompanyCorrectionContractor

SW SE NW

 Ft. from N. Line340 Ft. from S. Line990 Ft. from E. Line Ft. from W. Line

WILDCAT

SECTION PLAT

Location Rig up

Drilling and Remarks:

Reported as

Clay Bros. et al

RECORD

Cased in., ft.Sand Gas Oil Total Depth

PRODUCTION

1st 24 hrs. Nat. 1st 24 hrs. after shot Gas Cu. Ft.Dry Hole Abandoned

Date

APR 9 1941 19

S. J. LEWIS

Scout

