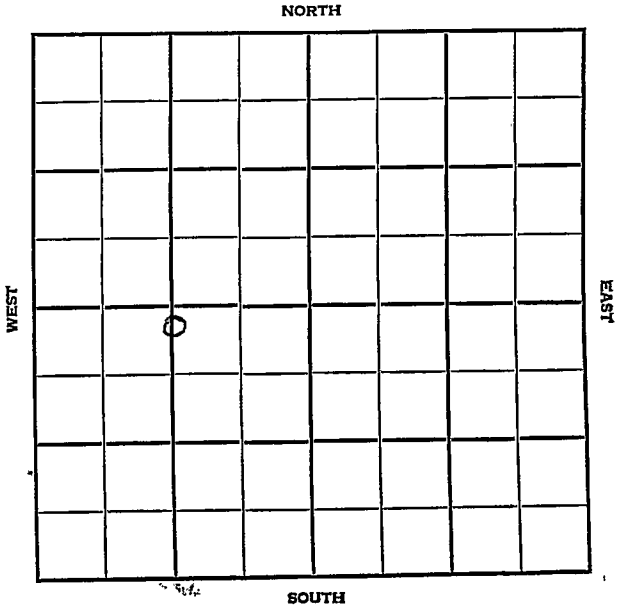


Section 15 Township 28 Range 32WWell No. #1 Schuette "A"Company Michaelis Drlg.

Haskell

KANSAS

SEC. 15	TWP. 28	R. 23 ² W 12
------------	------------	----------------------------

WELL NO.

#1 Schuette "A"

FARM

COMPANY

Michaelis Drlg.

CONTRACTOR

Hugoton


Ft. from N. Line

Ft. from S. Line

Ft. from E. Line

Ft. from W. Line

C N $\frac{1}{2}$ N $\frac{1}{2}$ SW 200' NL
1320'WL

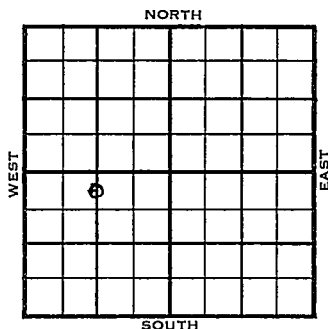

1955	ELEVATION 2950KB	REPORT
------	---------------------	--------

6/8

Comm 5-4-55

8 5/8" $\frac{1}{4}$ 574-300, 5 $\frac{1}{2}$ " @2741-300

CO to 2729 80/2708-28, sd-frac 12

open flow 3,930 mcfg Comp. 10 mcfgpd

Tops. Log:

Anh. Herr 2686

TP Kri 2706

H. Sh 2732

FIRST REPORT

+

COMPLETED

County Haskell Elev. 2950 KB
 Sec. 15 Twp. 28 Rge. 32W
 Company Michaelis Drlg.
 Farm Name Schuette "A" No. 1

TOPS	DEPTH	LOG	DATUM	Loc. in Sec.
Anh. <u>Harr</u>		<u>2686</u>		<u>C N$\frac{1}{2}$ N$\frac{1}{2}$ SW</u>
Tp. <u>Kri</u>		<u>2706</u>		
H. <u>56?</u>		<u>2732</u>		<u>200' NL</u>
Tr.				
Dg.				<u>1320' WL</u>
Bl.				
L.				Geol.
K.C.				Contr.
B.K.C.				
Ce.				
C.				
M.				Pool
M.				<u>Hugoton</u>
K.				
Mz.				
Me.				
V.				
S.				
S.				
A				
R.				
Pe.				
G.				
T.D.	<u>2742</u>			

Date Comm. 5-4-55 JUN 8 1955

8 5/8" @ 574/300 5 1/2" @ 2741-300

CO to 2729 80/ 2708-28 sd-frac

12 open flow 3,930 mcf/g

Comp. 10 mcf/gpd