


Ford KANSAS

DX 78-1

Section 15 Township 28 Range 21W

Well No. 1 Davis

Company W. J. Coppinger

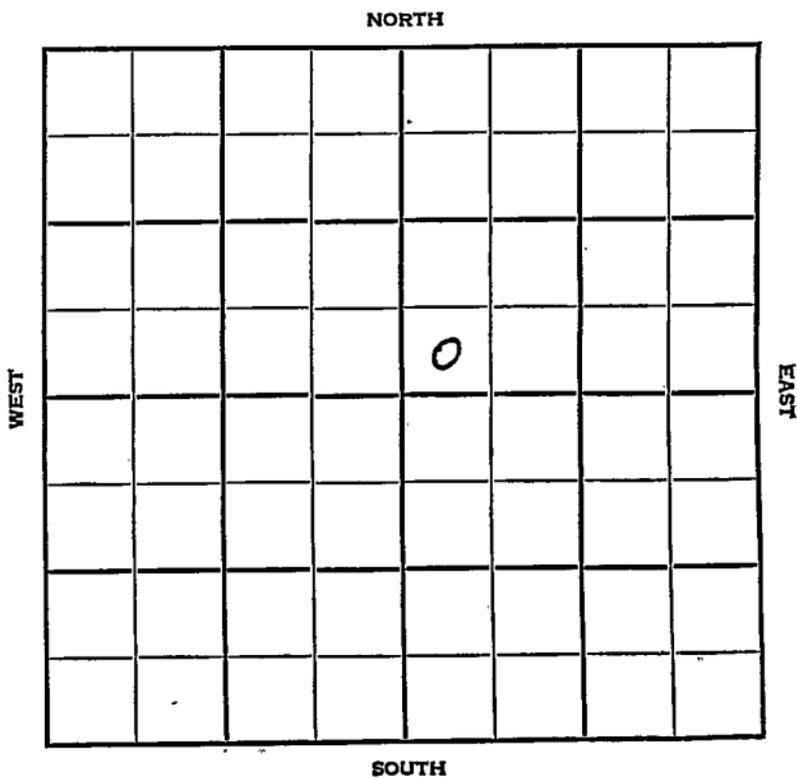

Ford

KANSAS

SEC.

TWP.

R.

15

28

21W ✓

WELL NO.

1 Davis

FARM

COMPANY

W. J. Coppinger

CONTRACTOR

Coppinger

Wildcat

Ft. from N. Line


Ft. from S. Line

Ft. from E. Line

Ft. from W. Line

330

330

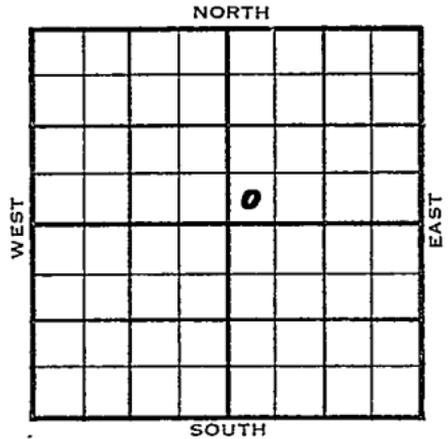

SW SW NE

Leslie Oil - Support

1954

ELEVATION

2381

REPORT

6/23

Spud 6-16-54
13" @ 315'
Drlg. 500'

6/30

" 4190

7/7

Heeb 4192 Lans. 4353
Drlg. 4900

7/14

Spdg 6-16-54
D&A
TD 5229
13" @ 315'
Heeb 4192 Lans. 4353 Anny 1355 Miss. -
5026
TD 5229
D&A**ABANDONED**


County Ford State Kansas

Sec. 15 (Blk. 28) (Sur. 21W) (Twp. 28) (Rge. 21W) Map No.

Operator W. J. Coppinger

Well No. 1 Farm Davis

Elev. 2381 Location SW SW NE

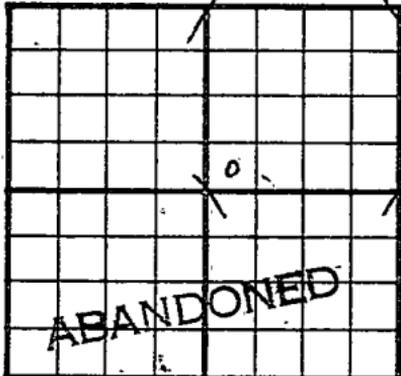

330 Ft. From S Line NE

330 Ft. From W Line Quarter

1st. Report

Completion JUL 14 1954

Remarks Wildcat

Coppinger - Contr.

Spudding Date 6-16-54

Drlg. Data D & A TD 5229

13" @ 315 Heeb. 4192 Lans. 4353

Anny 1355 Miss. 5026 TD 5229

D & A

J. G. McGEHEE

