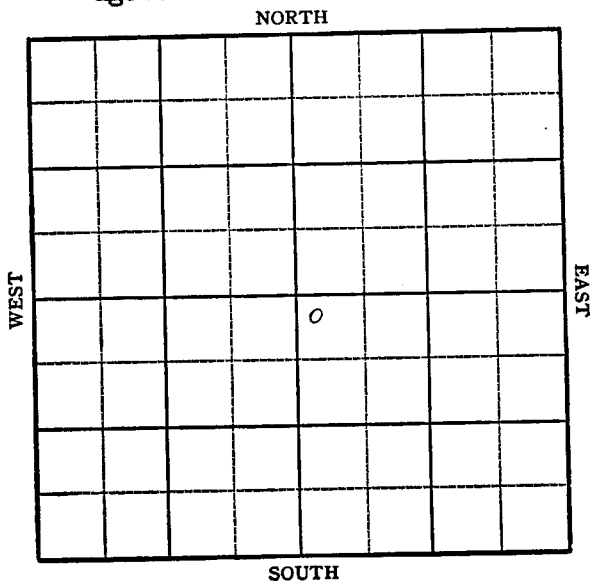


KANSASSection 15 Township 28 Range 40-WWell No. #1 BaughanCompany W E Bakke
Hugoton Pool

Sec. 15 Twp. 28 R. 40W ☒

Well No. #1 Baugham Farm

W. E. Bakke Company
Bugoton Pool (Bakke, Contr.)


200' Ft. from N. Line

 Ft. from S. Line

 Ft. from E. Line

200' Ft. from W. Line

NW SE

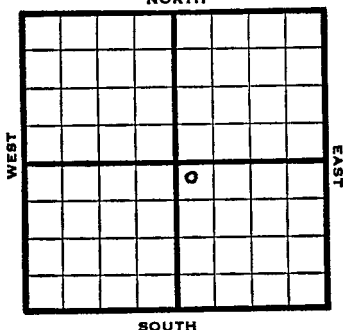

1949	Elev 3256' REPORT
11/30	10" @ 612'
12/7	TD 2260' 6" @ 2242'
12/14	Drilg. 2304'
12/21	TD 2304' 1000 acid
12/28	"
1950	
1/11	TD 2395' 10" @ 612' 6" set 2242' 16000 acid 3,600,000 gas opn flow Comp
	COMPLETED

Kansas

Map No. _____ Sec. 15 Twp. 28 R. 40W

Well No. 1 Baugham

W. E. Bakke

Company

Bakke

Contractor

NW SE

FIRST REPORT
SECTION PLAT

		o	

200 Ft. from N. Line

_____ Ft. from S. Line

_____ Ft. from E. Line

200
_____ Ft. from W. Line

Stanton County

Location _____

Rig up _____

Drilling and Remarks:

10" @ 612

RECORD

Cased _____ in., _____ ft.

Sand _____

Gas _____

Oil _____

Total Depth _____

PRODUCTION

1st 24 hrs. Nat. _____

1st 24 hrs. after shot _____

Gas _____ Cu. Ft.

Dry Hole _____

Abandoned _____

Date

NOV 30 1949

19

S. J. LEWIS

Scout

Map No. _____ Sec. 15 Twp. 28 R. 40WWell No. 1 Baughman


_____ W. E. Bakke _____ Company

_____ Contractor

NW SE

E1. 3256

SECTION PLAT

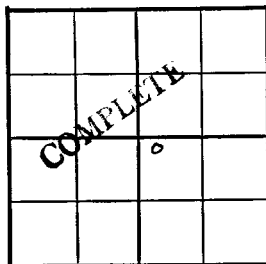200 Ft. from N. Line

_____ Ft. from S. Line

_____ Ft. from E. Line

200 Ft. from W. Line

Stanton County

Location _____

Rig up _____

Drilling and Remarks:

10" @ 612
 6" @ 2242
 16000 acid
 3,600,000 gas
 open flow

RECORD

Cased _____ in., _____ ft.

Sand _____

Gas _____

Oil _____

Total Depth 2395

PRODUCTION

1st 24 hrs. Nat. _____

1st 24 hrs. after shot _____

Gas _____ Cu. Ft.

Dry Hole _____

Abandoned _____

Date

JAN 11 1950

19

J. E. TYRA Scout