

DX 78-1

C.W.W.O.


Kiowa

KANSAS

Section 15 Township 28 Range 16W

Well No. #1 John Phillips

Company Gulf Oil Co.

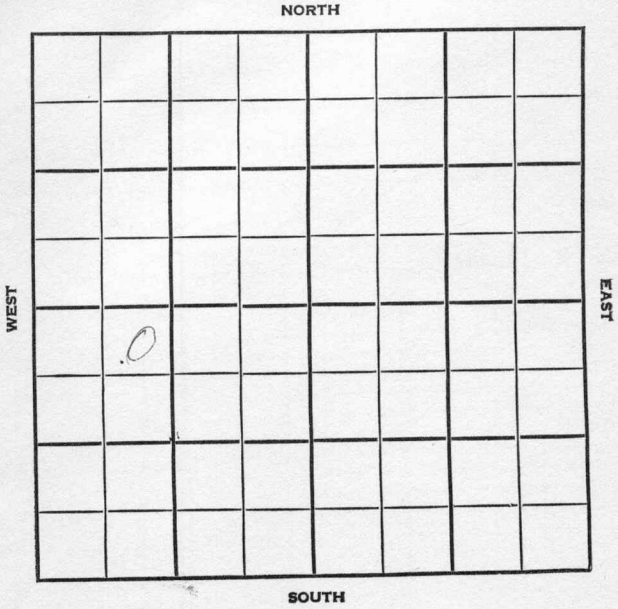

County Kiowa Elev. 2153
 Sec. 15 Twp. 28 Rge. 16W
 Company Gulf Oil Co.
 Farm Name John Phillips No. 1

TOPS	DEPTH	LOG	DATUM	Loc. in Sec.
Anh.				NE NW SW
Tr.				
H.	4006	4012		
Dg.	4068	4068		
Bl.	4169	4176		
L.	4186	4193		
K.C.				Geol.
B.K.C. <i>Marm</i>		4554		Contr.
Ce.	4700	4702		
C.				
M. <i>chert</i>	4716	4720		New zone Pool Wellisford
M.				
K. <i>sd</i>	4758	4761		
Mz.				
Me.				
V. <i>Li</i>		4786		COMPLETE
S. <i>Vio chert</i>		4797		
S.				
A.				
R.				
Pe.				
G.				
T.D.	4825			FEB 6 '57

Date Comm. NOV 20 '56
 Location NOV 20 '56 11-22-56
10 3/4 446 / 250 @ 2740 DEC 5 '56
@ 427 / DEC 12 '56 crd 4697-4718 new
21' DST 4694-4718 1 hr G/22"
TSTM new 420' Ho 6 GCM FP
130-210 BHP 1540/30 DST
4717-50 17' Md BHP 0/30"
DEC 19 '56 DIT 4786-4825 1 hr new
20' Md BHP 580/30 5 1/2 @ 4863/100

CO 4769 T69 to 4633 PF.

4723-32 4702-08 1/4

1/4 \$ 20 B0 DEC 26 '56 Frac

30 X 45 F19 Ld. JAN 2 '57

Flwd 50 B0 + 4 BW in 24 hrs

18/64" ch FTP 75 FCP 380

grav 34° JAN 9 '57 JAN 15 - JAN 23 '57

JAN 30 '57 X FEB 6 '57 T69 TO 4710

P. 15 Bopd + 4 BWpd.

grav 34°

County Kiowa Elev. _____
 Sec. 15 Twp. 28 Rge. 16W
 Company Gulf Oil Co.
 Farm Name John Phillips No. 1

TOPS	DEPTH	LOG	DATUM	Loc. in Sec.
Anh.				NE NW SW
Tp.				
H.				
Tr.				
Dg.				
BL.				
L.				Geol. _____
K.C.				Contr. _____
B.K.C.				
Ce.				
C.				
M.				
M.				Pool _____
K.				
Mz.				
Me.				
V.				
S.				
S.				
A.				
R.				
PE.				
G.				
T.D.				

	Nov 21 1935	
FIRST REPORT		

Date Comm. _____
 Location _____

~~25~~