


KANSAS - Pratt

FORM 51 5M PETROL

Section 15 Township 28 Range 12W

Well No. 2 John Chitwood

Company Lion Oil

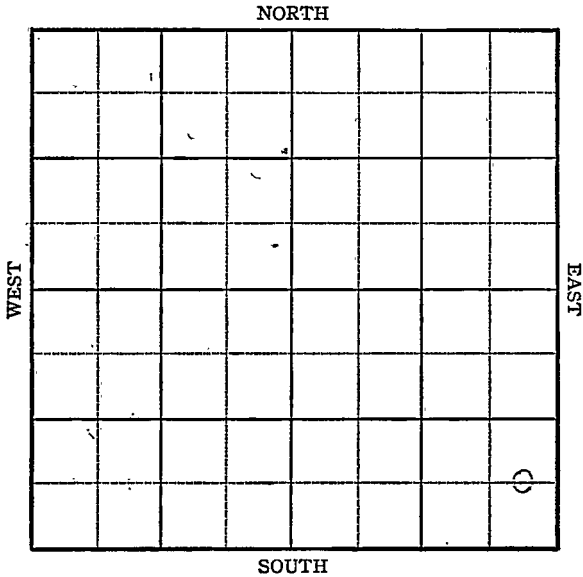

Sec. 15 Twp. 28 R. 12-W

Well No. #2 John Chitwood Farm


Lion Oil Company

_____ Ft. from N. Line

660 Ft. from S. Line

330 Ft. from E. Line

_____ Ft. from W. Line

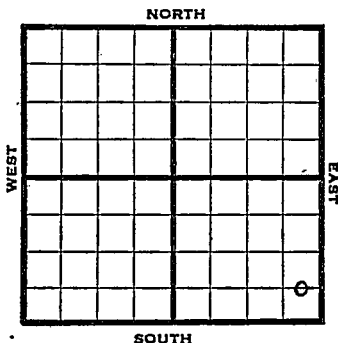

C E L S E S E

1945 Elev. 1878 . REPORT

9/19 RUR

9/26 9" @ 321
Drlg. 2360'

10/3 Drlg. 4131

10/10 Lans 3758
Viola 4373
TD 4450

5" @ 4443 RUST

10/17 Viola 4373

5" @ 4443
36 shots 4377-4381
500 acid.

TD 4450

Flow 539 oil plus 58 wtr. Pot.

Grav. 40.9

COMPLETED

KANSAS
 PETROL
 Kansas

 Pool Name Chitwood

 Map No. 5-H #2 Sec. 15 Twp. 28 R. 12W

 Well No. 2 John Chitwood
Lion Oil Company

FIRST REPORT Contractor

C E L S E S E

SECTION PLAT

 Ft. from N. Line

660 Ft. from S. Line

330 Ft. from E. Line

 Ft. from W. Line

Pratt County

Location _____

Rig up _____

Drilling and Remarks:

RUR

RECORD

Cased _____ in., _____ ft.

Sand _____

Gas _____

Oil _____

Total Depth _____

PRODUCTION

1st 24 hrs. Nat. _____

1st 24 hrs. after shot _____

Gas _____ Cu. Ft.

Dry Hole _____

Abandoned _____

Date

SEP 19 1945

19

S. J. LEWIS Scout

KANSAS

Kansas

Pool Name Chitwood

Map No. 54 Sec. 15 Twp. 28 R. 12W

Well No. 2 John Chitwood

Lion Oil Company

COMPLETED

Contractor

C E L S E S E

E. I. 1878
SECTION PLAT

 Ft. from N. Line

660 Ft. from S. Line

330 Ft. from E. Line

 Ft. from W. Line

Pratt County

Location

Rig up

Drilling and Remarks:

Viola 4829
5' @ 4443
36 shots 4377-81
500 cu ft
Flow 539 oil +
58 Water
40 @

RECORD

Cased in., ft.

Sand

Gas

Oil

Total Depth 4450

PRODUCTION

1st 24 hrs. Nat.

1st 24 hrs. after shot

Gas Cu. Ft.

Dry Hole

Abandoned

Date

OCT 17 1945 19

S. J. LEWIS

Scout