


Section 15 Township 28 Range 12 W

Well No. #1 J. V. Chitwood

Company Lion Oil Refg.

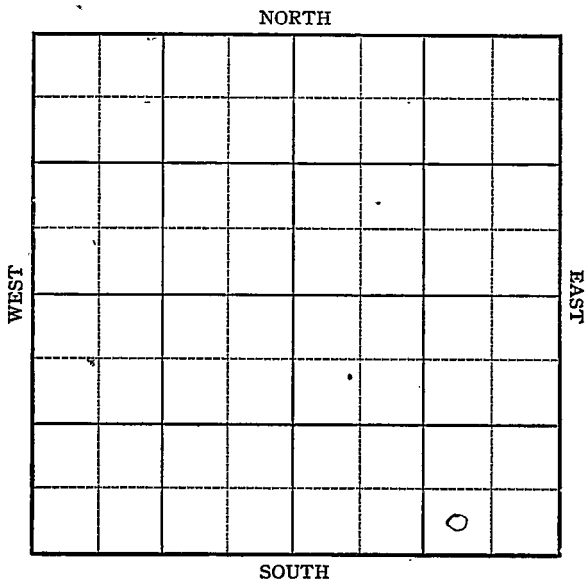


KANSAS

Pratt

Sec. 15 Twp. 28 R. 12 WWell No. #1 J. V. Chitwood FarmLion 0.1 Ref. Company

NORTH

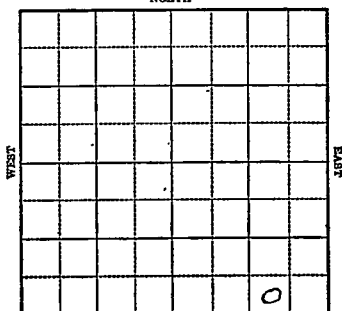

SOUTH

 Ft. from N. Line330 Ft. from S. Line990 Ft. from E. Line Ft. from W. LineElev. 1875

1943

R E P O R T

12/1 Derrick

12/8 8" @ 321 WOC

12-15 Drlg. 2750'

12/22 3300 fsg.

12/29 "

1944

1-5 PB 3000 Whipstock set at 3000
Drlg 3385'

1-12 Drlg 4113

Lans 3704

1/19 " "

1/26 Viola 4371

Simp Sdy Dolo 4465

Arb 4577

TD 4620

ABANDONED

KANSAS
 Map No. 24 Sec. 15 Twp. 28 R. 12W
 Well No. 1 J. V. Chitwood

Lion Oil Ref.


Company

FIRST REPORT

Contractor

SW SE SE

SECTION PLAT

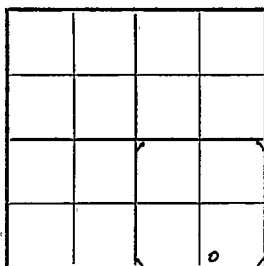

Ft. from N. Line

330 Ft. from S. Line

990 Ft. from E. Line

Ft. from W. Line

Chitwood Pool

Location

Rig up

Drilling and Remarks:

Derrick

RECORD

Cased _____ in., _____ ft.

Sand _____

Gas _____

Oil _____

Total Depth _____

PRODUCTION

1st 24 hrs. Nat. _____

1st 24 hrs. after shot _____

Gas _____ Cu. Ft.

Dry Hole _____

Abandoned _____

Date

DEC 1 1943 19

S. J. LEWIS Scout

KANSAS

Map No. 5 Sec. 15 Twp. 28 R. 12WWell No. 1 J. V. ChitwoodLion Oil Ref.


Company

ABANDONED

Contractor

SW SE SE

SECTION PLAT

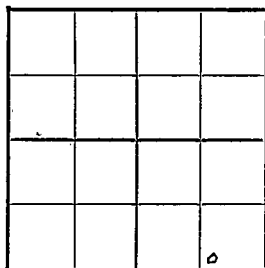

Ft. from N. Line

330

Ft. from S. Line

990

Ft. from E. Line

Ft. from W. Line

Chitwood Pool

Location

RECORD

Cased _____ in., _____ ft.

Sand _____

Gas _____

Oil _____

Total Depth #628

Drilling and Remarks:

Vis 4371Sing Gls. Tr. 4465CR 4577

PRODUCTION

1st 24 hrs. Nat. _____

1st 24 hrs. after shot _____

Gas _____ Cu. Ft.

Dry Hole _____

Abandoned _____

Date

JAN 26 1944

19

S. J. LEWIS Scout