

STATE CORPORATION COMMISSION OF KANSAS
OIL & GAS CONSERVATION DIVISION

WELL COMPLETION OR RECOMPLETION FORM
ACO-1 WELL HISTORY

DESCRIPTION OF WELL AND LEASE

Operator: License # 6892
Name Wenert Trich Oil & Gas
Address P.O. Box 1408
Longview, TX 75606
City/State/Zip

Purchaser UPG Falco, Inc.

Operator Contact Person Nathan Trich
Phone 214 758-0646

Contractor: License # 5829
Name Dideharan Drilling

Wellsite Geologist Terry McLeod
Phone 316 265-6431

Designate Type of Completion

☒ New Well ☐ Re-Entry ☐ Workover
☒ Oil ☐ SWD ☐ Temp Abd
☐ Gas ☐ Inj ☐ Delayed Comp.
☐ Dry ☐ Other (Core, Water Supply etc.)

If OWWO: old well info as follows:

Operator NA
Well Name
Comp. Date Old Total Depth

WELL HISTORY

Drilling Method:

☒ Mud Rotary ☐ Air Rotary ☐ Cable

8-28-85 9-6-85 9-24-85
Spud Date Date Reached TD Completion Date
4820' 4773'
Total Depth PBTD

Amount of Surface Pipe Set and Cemented at 472 feet
Multiple Stage Cementing Collar Used? ☐ Yes ☒ No
If yes, show depth set NA feet
If alternate 2 completion, cement circulated
from NA feet depth to w/ SX cmt

SIDE ONE

API NO. 15-097-21-175

County Kiowa

SE/4 Sec. 8 Twp. 28S Rge. 16 East West

370 Ft North from Southeast Corner of Section
2165 Ft West from Southeast Corner of Section

(Note: Locate well in section plat below)


Lease Name Frankhouser Well # 1

Field Name Wildcat

Producing Formation Mississippi

Elevation: Ground 2146' KB 2155'

Section Plat

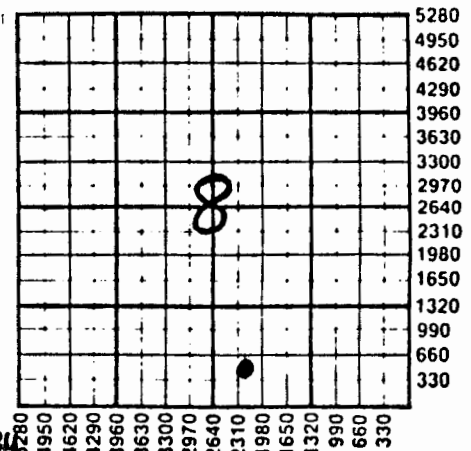

Survey

ANCH

WATER SUPPLY INFORMATION

Disposition of Produced Water: ☐ Disposal
Docket # ☐ Repressuring

Questions on this portion of the ACO-1 call:

Water Resources Board (913) 296-3717

Source of Water:

Division of Water Resources Permit #

☒ Groundwater 370 Ft North from Southeast Corner
(Well) 2130 Ft West from Southeast Corner of
Sec 8 Twp 28S Rge 16 East West

☐ Surface Water Ft North from Southeast Corner
(Stream, pond etc) Ft West from Southeast Corner
Sec Twp Rge East West

☐ Other (explain)
(purchased from city, R.W.D. #)

INSTRUCTIONS: This form shall be completed in duplicate and filed with the Kansas Corporation Commission, 200 Colorado Derby Building, Wichita, Kansas 67202, within 90 days after completion or recompletion of any well. Rule 82-3-130 and 82-3-107 apply.

Information on side two of this form will be held confidential for a period of 12 months if requested in writing and submitted with the form. See rule 82-3-107 for confidentiality in excess of 12 months.