

Section 16 Township 28 Range 5WWell No. #1 Palmer "B"Company Cities Service

NORTH

WEST

0							

EAST

SOUTH

Kingman

KANSAS

Sec. 16 Twp. 28 R. 5W

Well No. #1 Palmer "B" Farm

Cities Service Company

Barbour Drlg. - Contr. Contractor

Broadway Pool


330' Ft. from N. Line

_____ Ft. from S. Line

_____ Ft. from E. Line

330' Ft. from W. Line

NW NW NW

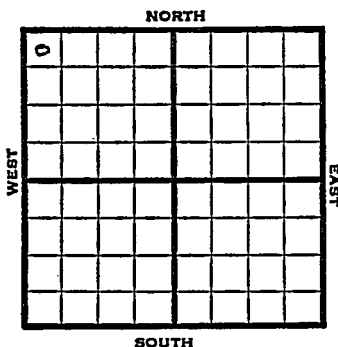

1951

Elev. 1399' REPORT


5/16

Location

7/18

Spud 6-2-51
Oil Well TD 3809
8" @ 194
Br Lime 2930 Lans. 2965
Miss 3762 Dol. 3789
DST 3780-3805 opn 22 min.
F/oil 100,000,000 gas 670' oil
TD 3805 5" @ 3805 DD 3809
500 A F/266 ho 15hr.
Comp. F/707 bopd

COMPLETED

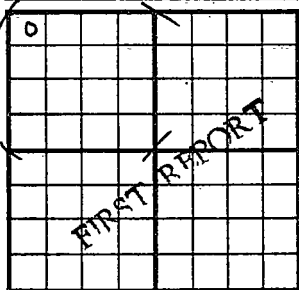County Kingman State KansasSec. 16 (Blk. Twp.) 28 (Sur. Rge.) 5W Map No. EOperator Cities ServiceWell No. 1 Farm Palmer "B"Elev. _____ Location NW NW NW330 Ft. From N Line NW330 Ft. From W Line Quarter1st. Report MAY 16 1951

Completion _____

Remarks _____

Barbour Drlg. - Contr.

Spudding Date _____

Drlg. Data Broadway Pool

Location _____

J. E. TYRA

County Kingman State Kansas
 Sec. 16 (Blk.) 28 (Sur.) 5W Map No.
 (Twp.) (Rge.)
 Operator Cities Service
 Well No. 1 Farm Palmer "B"
 Elev. 1399 Location NW NW NW

0			*			

COMPLETE

330 Ft. From N Line NW

330 Ft. From W Line Quarter

1st. Report

Completion JUL 18 1951

Remarks Broadway Pool

Barbour Drlg. - Contr.

Spudding Date 6-2-51

Drlg. Data Oil well TD 3809

8" @ 194 Br. line 2930 Lans. 2965

Miss. 3762 Dol. 3789 DST 3780-3805.

open 22 min. F/ oil 100,000,000 gas

670' oil TD 3805 5" @ 3805 DD 3809

500 A F/ 266 bo 15 hr. Comp. F/ 707 bopd

J. E. TYRA