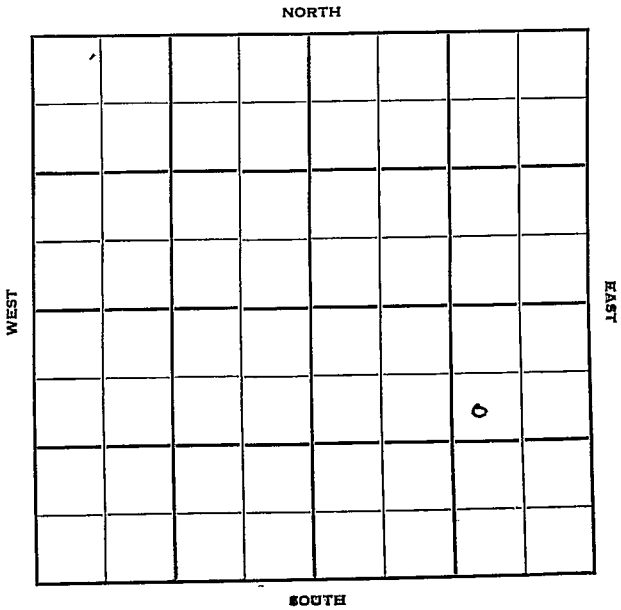


Section 16 Township 28 Range 5WWell No. #2 FoleyCompany Earl. Wakefield

KANSAS
28

Kingman

Sec. 16 Twp. 28 R. 5-W ✓

Well No. #2 Foley Farm

Earl Wakefield Company

Wakefield Contractor

Lansdowne


990 Ft. from N. Line

Ft. from S. Line

990 Ft. from E. Line

Ft. from W. Line

SW NE SE

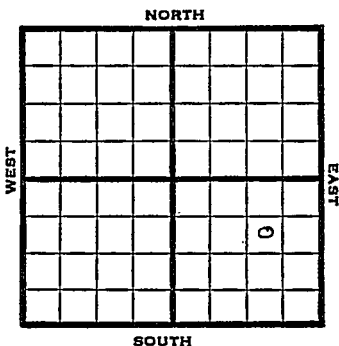

1950 Elev. 1397' REPORT

9/27 Spud 9-24-50
8" @ 140


WOC

12/27 Spud 9-24-50
Oil Well TD 3830
8" @ 140' Miss 3783
Miss Dol. 3820
TD 3830 F/25 bopd
Comp. 22 bopd

COMPLETED

J. E. TYRA

County Kingman State Kansas
 Sec. 16 (Blk.) 28 (Sur.) 5W Map No.
 Operator Earl Wakefield
 Well No. 2 Farm Foley
 Elev. 1397 Location SW NE SE

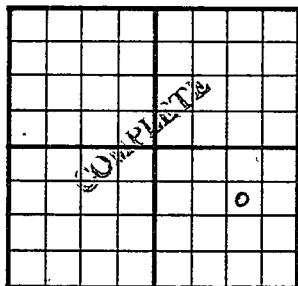

990 Ft. From N Line SE
990 Ft. From E Line Quarter
 Ist. Report
 Completion DEC 27 1950
 Remarks Lansdowne Pool
Wakefield - Contr.
 Spudding Date 9-24-50

Drlg. Data Oil well TD 3830
8" C 140 Miss. 3783 Miss. dol. 3820
TD 3830 F/ 25 bopd Comp. 22 bopd

J. E. TYRA