


Section 16 Township 28 Range 5-W

Well No. #1 Foley

Company Earl Wakefield

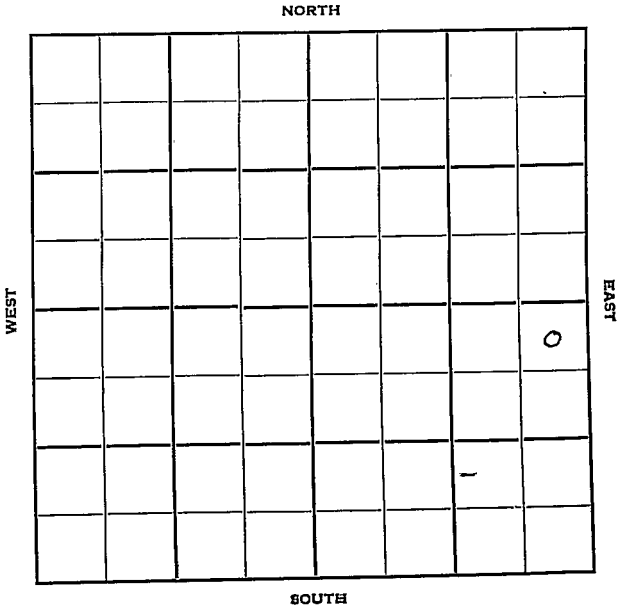

Sec. 16 Twp. 28 R. 5-W

Well No. #1 Foley Farm

Earl Wakefield Company

Bartholomew Contractor


330 Ft. from N. Line

 Ft. from S. Line

330 Ft. from E. Line

 Ft. from W. Line

NE NE SE

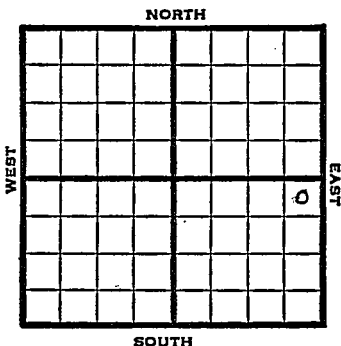

1950

Elev 1406' REPORT

9/6

Spud 9-3-50
8 5/8" @ 140
WOC

1951

1/17

8 5/8" @ 140

Lans 2985

Miss 3786

TD 3830

5" @ 3814


Comp 103 bopd

4% water

Completed

COMPLETED

1
2
3

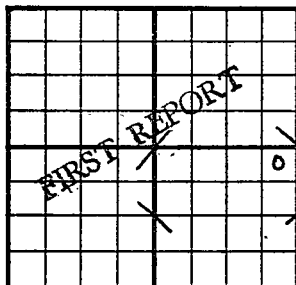
County Kingman State KansasSec. 16 (Blk.) 28 (Sur.) 5W Map No.Operator Earl WakefieldWell No. 1 Farm FoleyElev. _____ Location NE NE SE330 Ft. From N Line SE330 Ft. From E Line Quarter1st. Report SEP 6 1950

Completion _____

Remarks _____

Spudding Date 9-3-50Drlg. Data Bartholomew Pool8 5/8" @ 140 WOC

J. E. TYRA

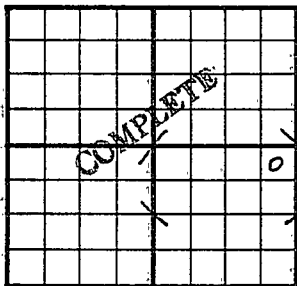County Kingman State KansasSec. 16 (Blk. Twp.) 28 (Sur. Rge.) 5W Map No.Operator Earl WakefieldWell No. 1 Farm FoleyElev. 1406 Location NE NE SE330 Ft. From N Line SE330 Ft. From E Line Quarter

1st. Report

Completion JAN 17 1951Remarks Bartholomew PoolSpudding Date 9-3-50Drilg. Data Oil well TD 38308 5/8" @ 140 Lans. 2985 Miss. 3786TD 3830 5" @ 3814 Comp. 103 bopd4% water

J. E. TYRA