

Sec. 16 Twp. 28 R. 5W ✓

Well No. #1 Hobbs Farm

E. F. Wakefield Company

Broadway Pool Contractor


Ft. from N. Line

330' Ft. from S. Line

330' Ft. from E. Line

Ft. from W. Line

SE SE SW

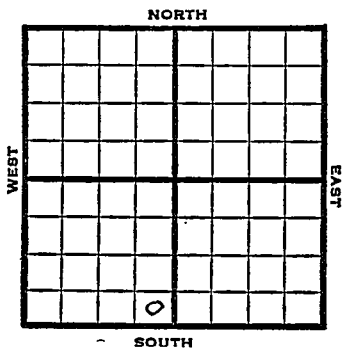

1951

Elev. 1388' REPORT

2/28

Location

5/9

Spud 2-28-51
 Oil Well TD 3828
 8" @ 130
 Miss 3779 Dol. 3806
 5" @ 3807 TD 3828
 F/45 bopd F/25 bopd
 Comp F/153 bopd 3% wtr.

COMPLETED


County Kingman State Kansas

Sec. 16 (Blk. 28 (Sur. Rge.) 5W Map No.

Operator E. F. Wakefield

Well No. 1 Farm Hobbs

Elev. 1388 Location SE SE SW

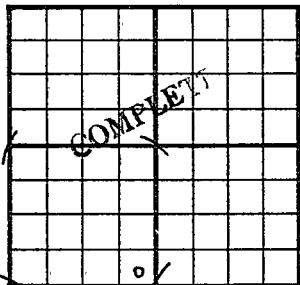

330 Ft. From S Line SW

330 Ft. From E Line Quarter

Ist. Report

Completion MAY 9 1951

Remarks Broadway Pool

Spudding Date 2-28-51

Drlg. Data Oil well TD 3828

8" @ 130 Miss. 3779 Dol. 3806

5" @ 3807 TD 3828 F/ 45 bopd

F/ 25 bopd Comp. F/ 153 bopd 3% water

J. E. TYRA