

Kingman KANSAS

Section 16 Township 28 Range 5W

Well No. #1 Foley

Company Kingwick Oil

NORTH

						0	

WEST

EAST

SOUTH

Kingman

Sec. 16 Twp. 28 R. 5W ✓

Well No. #1 Foley Farm

Kingwick Oil Company

Sterling Drlg. Contr. Contractor

Landsdown Pool


 Ft. from N. Line

990' Ft. from S. Line

990' Ft. from E. Line

 Ft. from W. Line

NW SE SE

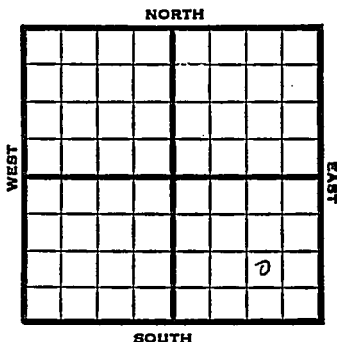

1950 Elev. 1394' REPORT

12/20 RUR

1951

2/28

Oil Well TD 3825

8" @ 200 Miss 3783

Chert 3800 Dol. 3820

TD 3825

5" @ 3820

FU 500' oil. 500 A F/12 boph

Comp. 240 bopd

COMPLETED

County Kingman State KansasSec. 16 (Blk.) 28 (Sur.) 5W Map No.Operator Kingwick OilWell No. 1 Farm FoleyElev. 1394 Location NW SE SE

FIRST REPORT

990 Ft. From S Line SE990 Ft. From E Line Quarter1st. Report DEC 20 1950

Completion


Remarks

Sterling Drlg. - Contr.

Spudding Date

Drlg. Data Landsdown PoolRUR

J. E. TYRA

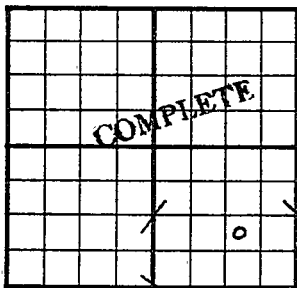County Kingman State KansasSec. 16 (Blk.
Twp.) 28 (Sur.
Rge.) 5W Map No.Operator Kingwick OilWell No. 1 Farm FoleyElev. 1394 Location NW SE SE990 Ft. From S Line SE990 Ft. From E Line Quarter

1st. Report

Completion FEB 28 1951Remarks Lansdowne PoolSterling Drlg. - Contr.

Spudding Date

Drlg. Data Oil well TD 38258" @ 200 Miss. 3783 Chert 3800Dol. 3820 TD 3825 5" @ 3820FU 500' oil 500 A F/ 12 bophComp. 240 bopd

J. E. TYRA