

KANSAS

Section 16 Township 28 Range 33-W

Well No. #1 Porter

Company National Assoc. Pet.

NORTH

				0			

WEST

EAST

SOUTH

Sec. 16 Twp. 28 R. 33W

Well No. #1 Porter Farm

National Assoc. Pet. Company

Kuhn -Contr. Contractor

Hugoton Pool

Ft. from N. Line


100'

Ft. from S. Line

Ft. from E. Line

100'

Ft. from W. Line

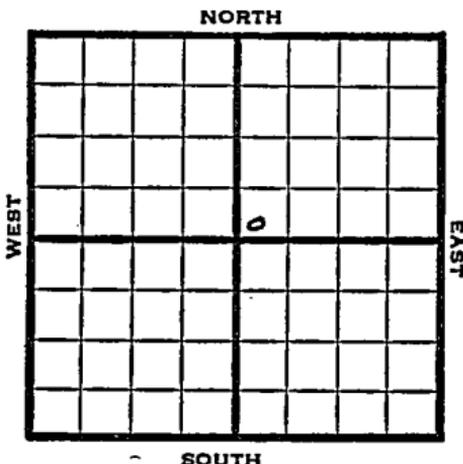

SW NE

Elev. 2981' REPORT

1950

11/15

Spud 10-27-50
Loc.

1951

2/21

Spud 10-27-50
Gas Well TD 2768
10" @ 685' 5" @ 2728
TD 2758 Her 2660
Krider 2702 Win 2729
252/2660-2702
23,000A Comp. 14,807,000 Gas
412#

COMPLETED

County Haskell State Kansas

Sec. 16 (Blk. Twp.) 28 (Sur. Rge.) 33W Map No.

Operator National Assoc. Pet.

Well No. 1 Farm Porter

Elev. 2981 Location SW NE

100 Ft. From S Line NE

100 Ft. From W Line Quarter

Ist. Report NOV 15 1950

Completion _____

Remarks _____

Kuhn - Contr.

Spudding Date 10-27-50

Drlg. Data loc Hugoton Pool

