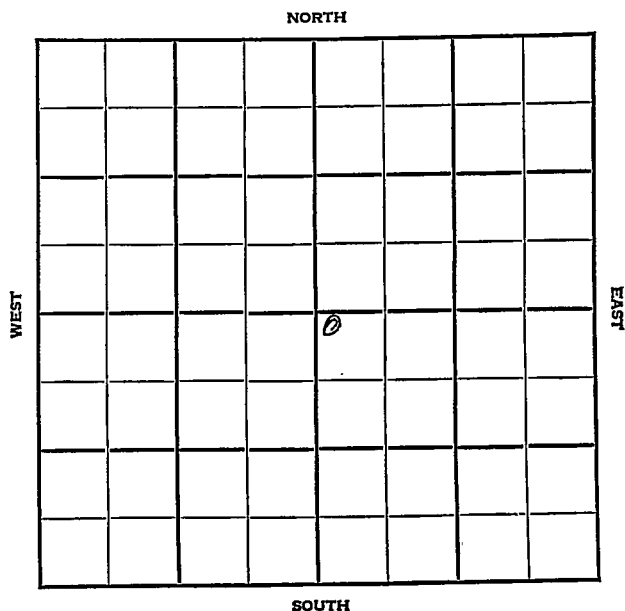


Section 16 Township 28 Range 34 WWell No. #1 FlecherCompany Northern Natural Gas

KANSAS

Haskell

Sec. 16 Twp. 28 R. 34W ✓

Well No. #1 Flecher Farm

Northern Natural Gas Company


Hugoton Pool

200' Ft. from N. Line

 Ft. from S. Line

 Ft. from E. Line

200' Ft. from W. Line

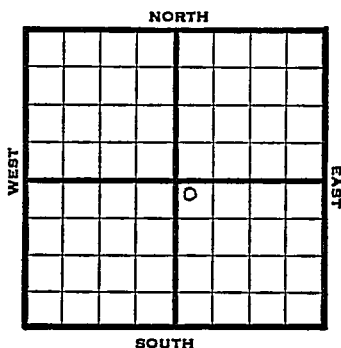

NW SE

1948

Eli 3044'

R E P O R T

7/14 Location

7/21 Drlg 193'

7/28 10"@ 537'
7"@ 2544'
TD 2558'

8/4 "

8/11 "

8/18 "

8/25 TD 2758'
250' of 5" perf Liner @ 2785'

9/1 21,000 acid

9/8 "

9/15 7"@ 2544'
250' of 5" Perf liner @ 2785 TD
21000 acid
14,113,000 gas
410# R Pr.
Comp

COMPLETED

Map No. _____ Sec. 16 Twp. 28 R. 34W

Well No. 1 Flecher

Northern Natural Gas

Company

FIRST REPORT

Contractor

NW SE

SECTION PLAT

200 Ft. from N. Line

_____ Ft. from S. Line

_____ Ft. from E. Line

200 Ft. from W. Line

		0	

Haskell County

Location X

Rig up _____

Drilling and Remarks:

RECORD

Cased _____ in., _____ ft.

Sand _____

Gas _____

Oil _____

Total Depth _____

PRODUCTION

1st 24 hrs. Nat. _____

1st 24 hrs. after shot _____

Gas _____ Cu. Ft.

Dry Hole _____


Abandoned _____

Date

JUL 14 1948 19

S. J. LEWIS

Scout

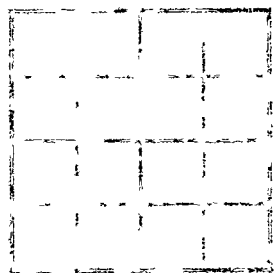


- Misc. Small Maps
- Cards
- Tracing
- France Map
- Scarborough Map
- Pierce Map
- Geological Dept
- Pierce Plot Book


Haskell County Kansas State

Map No. _____ Sec. 16 Twp. 28 R. 34W

Well No. 1 Flecher

Northern Natural Gas Company

COMPLETE Contractor

NW SE -

E1,2044
SECTION PLAT

200 Ft. from N. Line

_____ Ft. from S. Line

_____ Ft. from E. Line

200 Ft. from W. Line

Hugoton Pool

Remarks:

7 "C2544

250' of 5" Prof liner @ 2755 TD

21000 ac

14, 113,000 lbs

410 # RFE

Date
SEP 15 1948

Scout
S. J. LEWIS

Misc. Small Maps _____
Cards Smith
Tracing _____
France Map ✓
Scarborough Map ✓
Pierce Map ✓
Geological Dept. _____
Pierce Plat Book _____