


Section 16 Township 28 Range 39WWell No. 1 SpurgeonCompany Stanolind

Hugoton

NORTH

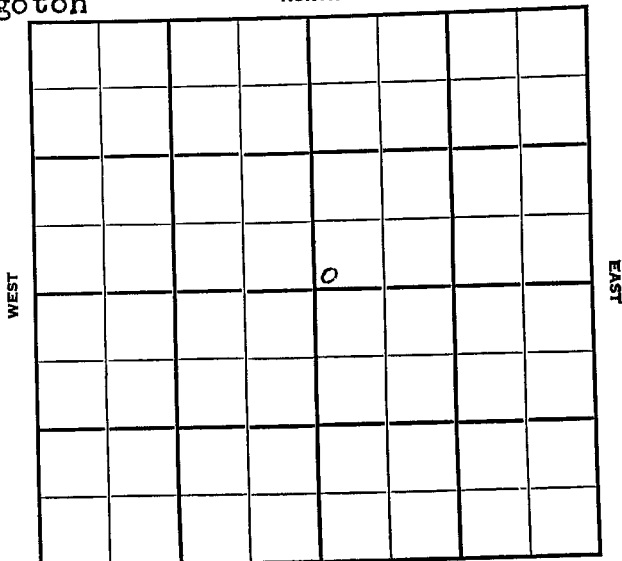


SOUTH

Stanton

Sec. 16 Twp. 28 R. 39W ✓

Well No. #1 Spurgeon Farm
Stanolind Company

Hugoton
Ft. from N. Line
50
Ft. from S. Line
Ft. from E. Line
50
Ft. from W. Line

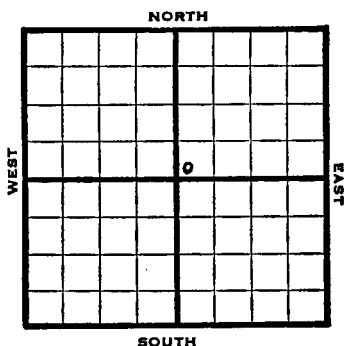

SW NE

1947 Elev. 3159' REPORT

11/5	8" @ 686 WOC
11/12	Drlg. 2331'
11/19	TD 2450'
	5" @ 2421'
11/25	"
12/3	"
12/10	"
12/17	"
12/30	"
1948	
1/7	"
1/14	"
1/21	"
1/26	"
2/4	"
2/11	TD 2460' - 10000 acid.
2/18	"
2/25	"
3/3	"
3/10	"
3/17	"
3/24	"

OVER

1948

3/31	132 shots	2380-2402	3500 Acid
	232 "	2312-34	3500 "
	240 "	2252-92	5500 "

4/7 "

4/14 5" @ 2421'
Perf.
13,500 acid
5,050,000 gas.
440# R. Pr.
TD 2460'
Comp.

COMPLETED

Map No. 104612 Sec. 16 Twp. 28 R. 39W


Well No. 1 Spurgeon

Stanclind Company

COMPLETE Contractor

SW NE

E. J. N. F.
SECTION PLAT

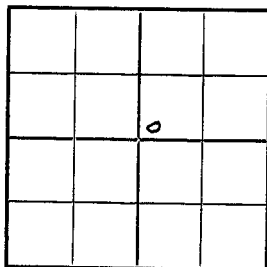

 Ft. from N. Line

50 Ft. from S. Line

 Ft. from E. Line

50 Ft. from W. Line

Stanton County

Location

Rig up

Drilling and Remarks:

5" C2424

Perf.

13500 acid

5,050,000 Gas

*440 * R/A*

RECORD

Cased in., ft.

Sand

Gas

Oil

Total Depth 2460

PRODUCTION

1st 24 hrs. Nat.

1st 24 hrs. after shot

Gas Cu. Ft.

Dry Hole

Abandoned

Date

APR 14 1948 19 S. J. LEWIS Scout

Map No. _____ Sec. 16 Twp. 28 R. 39W

Well No. 1 Spurgeon

Stanolind Company

1ST REPORT Contractor

SW NE


SECTION PLAT

_____ Ft. from N. Line

50 Ft. from S. Line

_____ Ft. from E. Line

50 Ft. from W. Line

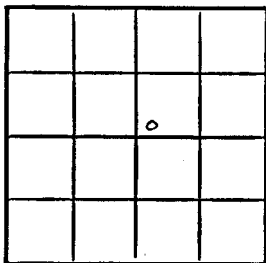

Stanton County

Location _____

Rig up _____

Drilling and Remarks:

8" @ 686 WO

RECORD

Cased _____ in., _____ ft.

Sand _____

Gas _____

Oil _____

Total Depth _____

PRODUCTION

1st 24 hrs. Nat. _____

1st 24 hrs. after shot _____

Gas _____ Cu. Ft.

Dry Hole _____

Abandoned _____

Date

NOV 5 1947

19

S. J. LEWIS

Scout