


Kiowa

KANSAS

SECTION 16 TOWNSHIP 28S RANGE 16W

WELL NO. #1 Kinney "B"

COMPANY El Dorado

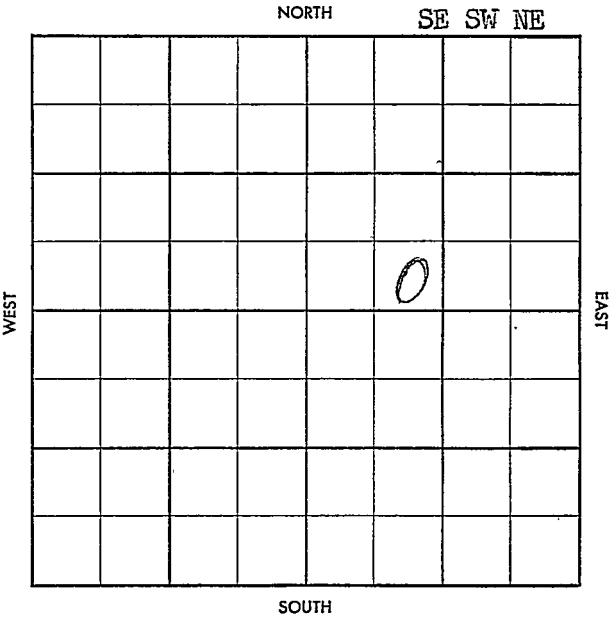

Kiowa

KANSAS


SEC. 16	TWP. 28 S	R. 16 W
------------	--------------	------------

WELL NO. # 1 Kinney FARM

COMPANY El Dorado

CONTRACTOR Prime Drlg.

_____ FT. FROM N. LINE
 _____ FT. FROM S. LINE
 _____ FT. FROM E. LINE
 _____ FT. FROM W. LINE

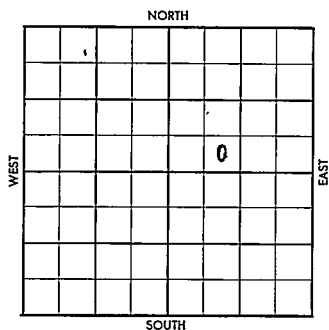

SE SW NE

SDX-1/4 Mile

1957	ELEVATION	REPORT
------	-----------	--------

9/18	Location	(FR Tkt)
------	----------	----------

25

County ~~Kiowa~~ Elev. _____
 Sec. 16 Twp. 28 Rgs. 16W
 Company Eldorado
 Farm Name Kinney No. 1

Co.

TOPS	DEPTH	LOG	DATUM
Anh.			
Tr.			
H.			
Tr.			
Dg.			
Bl.			
L.			
K.C.			
B.K.C.			
Ce.			
C.			
M.			
M.			
K.			
Mz.			
Mq.			
V.			
S.			
A			
R.			
Pe.			
G.			
T.D.			

Loc. in Sec. _____
 SE SW NE
 Geol. _____
 Contr. _____
 Prime Drlg.
 Pool _____

Lse.

SEP 18 '57	
FIRST REPORT	

Int.

Date Comm. _____ SDX - 1/4 MILE
 Location _____

Sec.

T.

R.

10
 A.M.

OCT 30 '57 FID 40 B L 0 1,500 MCF

NOV 6 '57 FID 40 B 3 3/4" ch

ga 969 MCF TP 160

FID 6.68 B0 Wogas 18 1/2

WTP TP 65 NOV 13 '57 NOV 20 '57

NOV 27 '57 DEC 4 '57 DEC 11 '57 P 11 B0 NW

24 hrs P 4.19 B0 24 hrs

1 '57 DEC 26 '57 JAN 2 '58

P & FID 40 B0 pd 100 MCF
NW

MISS 4727 -32

16-28-66W

SE SW NE

Kinney "B" Kiewa