


Map No. KANSAS Sec. 16 Twp. 28 R. 7^W
 Well No. 1- Ashcraft Farm
Fleeger et al Company

NORTH

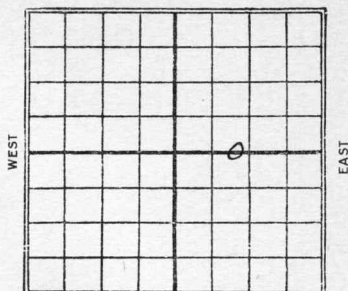

2640 Ft. from N. Line

_____ Ft. from S. Line

1570 Ft. from E. Line

_____ Ft. from W. Line

SOUTH

1929

Elev. 1536 L+S

Date _____ REPORT 4400' test

8/28	Loc.		
9/4	Rig		
9/11	Rign up		
9/18	Spud		
9/25	Wlg 960	3948	4343
10/2	" 1610'	1536	1536
10/9	" 1910'	2412	2807
10/16	no report		
10/23	Wily 2510'		
10/30	" 3085'		
11/6	W/R 8"- 3250'		
11/13	Wlg 3498'		
11/20	" 3650'		
11/27	6"- 3740 Wlg 3755'		
12/4	W/R 6"- 3930'		
12/11	2 nd Chat 3970' Show gas and 600' water in hole	3948	
12/18	W/R 5" Top Chat 3948' (SLM) TD 3970' bad hole		
12/23	Wily 4005'		
12/30	" 4095'		

1930

1/8 - Wilcox 4343-50' HFW

SD. 4420' T.D.

1/15 - SD 4445'

1/22 —

1/29 - SD. 4500'

2/3 - Dalg. 45-25-

2/12 - T.D. 4535'

Dry & Abandon

Map No. KANSAS Sec. 16 Twp. 28 R. 7W

Well No. 1 Ashcraft

Fleeger & Lab Company

Contractor


SECTION PLAT

2640 Ft. from N. Line

..... Ft. from S. Line

1570 Ft. from E. Line

..... Ft. from W. Line

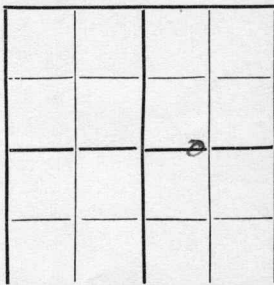

FIRST REPORTS

Location ✓

Rig up

Drilling and Remarks:

4400 ft test

RECORD

Cased in., ft.

Sand

Gas

Oil

Total Depth

PRODUCTION

1st 24 hrs. Nat.

1st 24 hrs. after shot

Gas Cu. Ft.

Dry Hole


Abandoned

Date

AUG 28 1929

S. J. LEWIS Scout

SECTION PLAT

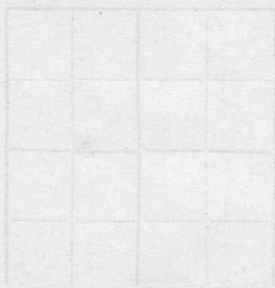

see you

Returned	<i>OK</i>
Cards	<i>OK</i>
Tracing	<i>OK</i>
France Map	<i>None</i>
Scarborough Map	<i>X</i>
Moody Map	
Scarborough Plot Book	
Moody Plot Book	

Kingman
 Map No. *KANSAS* Sec. *16* Twp. *28* R. *24*

Well No. *1 Aschey &*

Fleeger & Co. Company

Contractor


SECTION PLAT

2640 Ft. from N. Line

Ft. from S. Line

1570 Ft. from E. Line

Ft. from W. Line

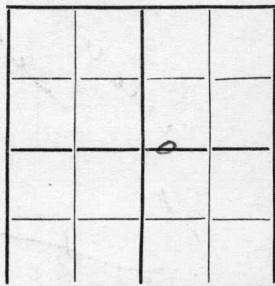

ABANDONED

Location.....

Rig up.....

Drilling and Remarks:

RECORD

Cased.....in.,ft.

Sand.....

Gas.....

Oil.....

Total Depth *4535*

PRODUCTION

1st 24 hrs. Nat.....

1st 24 hrs. after shot.....

Gas.....Cu. Ft.

Dry Hole.....

Abandoned.....

Date

FEB 12 1930

192

S. J. LEWIS Scout

no wall
see

Returned	TB
Cards	
Tracing	OK
France Map	X
Scarborough Map	X
Moody Map	X
Scarborough Plot Book	
Moody Plot Book	