


Section 17 Township 28 Range 5W

Well No. #1 Viney

Company Pabco Drlg.

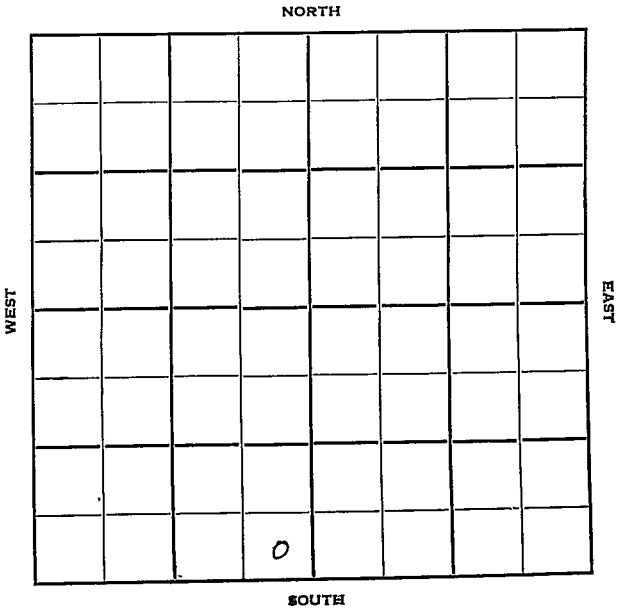

Sec. 17 Twp. 28 R. 5-W ✓

Well No. #1 Viney Farm

Pabco Drlg. Company

Pabco Contractor

Wildcat


_____ Ft. from N. Line

330 Ft. from S. Line

330 Ft. from E. Line

_____ Ft. from W. Line

SE SE SW

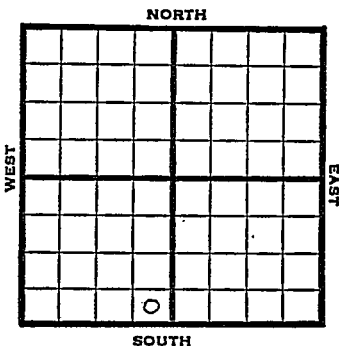

1950

Elev 1417 REPORT

10/4

Spud 9-29-50
8 5/8" @ 150
drlg 890

11/8

8 5/8" @ 150
Miss 3837
DST 3837-50 opn 1 1/2 hr rec 68' so&gcm
DST 3852-87 gas to surface in 23 min
opn 1 hr rec 300' gassy mud SSO
DST 3882-95 TD
opn 1 hr rec 150' ocm
5" @ 3882
1 1/2 bo 2 bw 7 hr 500 A
S/15 bo 35 bw 15 hr
2500 A
S/18 bo 70 bw 14 hr
S/2 1/2 bo 64 bw 18 hr SP 3890
96/3840-55 water
TD 3895
D&A
ABANDONED

Scout Cards F W
Land Small Map
Land Wall Map
Tracings
France Map
Pierce Map
Misc.

DCT 6 1950

Scout Cards	7 (w)
Land & Natl Map	
Trail Map	
State Map	
Home Map	
MISC.	

NOV 13 1950

Prig. Data