

Section 17 Township 28 Range 5-WWell No. #1 PilgrimCompany Atlantic Ref.

NORTH

							6

WEST

EAST

SOUTH

Sec. 17 Twp. 28 R. 5W ✓

Well No. #1 Pilgrim Farm

Atlantic Refg. Company

Wakefield - Contr. Contractor

Dewey Pool


330' Ft. from N. Line

_____ Ft. from S. Line

330' Ft. from E. Line

_____ Ft. from W. Line

NE NE NE

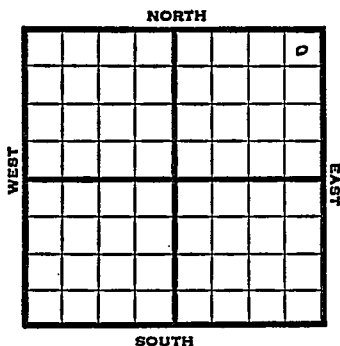

1950 Elev. 1399' REPORT

12/27 MIRT

1951
4/18

Spud 12-29-51
Gas Well TD 3860
8" @ 870'
Br Lime 2948 Lans. 2972
Miss 3757' Dol. 3791
DST 3792-3802 opn 1 hr
Gas in 4 min.
Est. 4 mcf/g 180' hgem
DST 3802-12 opn 1 hr
Rec. 90' mud & SSO TD 3860
5" @ 3860 36/3814-20 500 A
F/1 bo 1 bwph & 900,000 gas
F/800,000 gas 1 bw 2 bo oil dec.
F/1,900,000 gas 14 bwph
30/3805-10 S/5 gw 6½ hr. 500 A
F/14 bo 30 bw 3 hr F/10 bw
1,250,000 gas 30/3800-05 F/15 bw
SSO 1¼ mcf/g Comp. 1,150,000 gas pd

COMPLETED

J. E. TYRA

County Kingman State Kansas
 Sec. 17 (Blk.) 28 (Sur.) 5W Map No.
 Operator Atlantic Ref.
 Well No. 1 Farm Pilgrim
 Elev. 1399 Location NE NE NE

							0

330 Ft. From N Line NE
330 Ft. From E Line Quarter
 1st. Report
 Completion APR 1.8 1951
 Remarks Dewey Pool
Wakefield - Contr.
 Spudding Date 12-29-51

Drilg. Data Gas well TD 3860
8" @ 870 Br. lime 2948 Lans. 2972
Miss. 3757 Dol. 3791 DST 3792-3802
open 1 hr. Gas in 4 min. Est. 4 mcfg
180' hgcm DST 3802-12 open 1 hr.
Rec. 90' mud & SS0 TD 3860 5" @ 3860
36/ 3814-20 500 A F/ 1 bo 1 bwph
& 900,000 gas F/ 800,000 gas 1 bw 2 bo
oil dec. F/ 1,900,000 gas 14 bwph
30/ 3805-10 S/ 5 gw 6 $\frac{1}{2}$ hr. 500 A
F/ 14 bo 30 bw 3 hr. F/ 10 bw 1250000
30/ 3800-05 F/ 15 bw SS0 1 $\frac{1}{4}$ mcfg
Comp. 1,150,000 gas pd

J. E. TYRA

County Kingman State Kansas
 Sec. 17 (Blk. Twp.) 28 (Sur. Rge.) 5W Map No.
 Operator Atlantic Ref.
 Well No. 1 Farm Pilgrim
 Elev. 1399 Location NE NE NE

						0

COMPLETE

330 Ft. From N Line NE
 330 Ft. From E Line Quarter
 1st. Report 12-27-50
 Completion 4-18-51
 Remarks Dewey Pool
Wakefield - Contr.
 Spudding Date 12-29-50

Drlg. Data Gas well TD 3860
 8" @ 870 Br. lime 2948 Lans. 2972
 Miss. 3757 Dol. 3791 DST 3792-3802
 open 1 hr. gas in 4 min. est 4 mcfg
 180' hgcm DST 3802-12 open 1 hr.
 Rec. 90' mud & SSO TD 3860 5" @ 3860
 36/ 3814-20 500 A F/ 1 bo 1 bwph
 900,000 gas F/ 800,000 gas 1 bwph 2 bo
 F/ 1,900,000 gas 14 bwph sq. off
 30/ 3805-10 S/ 5 gw 6½ hr. 500 A
 F/ 14 bo 30 bw 3 hr. F/ 10 bw no oil
 1,250,000 gas 30/ 3800-05 F/ 15 bw &
 SSO F/ 2 bo 23 bwph 1,960,000 gas
 Comp. 1,150,000 gas

Suppl. ite J. E. TYRA