

Company E. Wakefield

NORTH

WEST

EAST

SOUTH

Sec. 17 Twp. 28 R. 5 W

Well No. # 1 Broadway "B" Farm

E. Wakefield Company

Contractor

Broadway Pool


Ft. from N. Line

330 Ft. from S. Line

330 Ft. from E. Line

Ft. from W. Line

SE SE SE

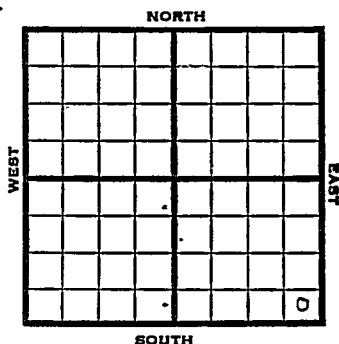

1951 Elev. 1383' REPORT

8/22 Location

1952

2/6 TD 4864 5" @ 4330

2/13 NR

2/20 "

3/5 "

3/12 "

3/19 "

3/25 "

4/1 "

4/9 "

4/23 "

4/30 "

5/7 "

5/14 "

5/21 "

5/28 "

6/11 "

6/18 16/3805-89* 500 A S/17 BF 24 hrs.
12 BO & 5 BW Est 1 M gas.

6/25 NR

7/2 NR

7/9 NR

OVER

1952
7/17 NR
7/23 "
7/30 "
8/6 "
8/13 "
8/20 "
8/27 "
9/3 "
9/10 Spud 11-15-51
SWD well TD 4864'
8" @ 122'
Lans. 2991 Miss. 3789
Arb. 4329
TD 4864' 5" @ 4330'
Comp. for SWD well

ABANDONED




J. E. TYRA

Scout Cards	mm
Land Small Map	
Land Wall Map	5
Tracings	
France Map	
Pierce Map	
Misc.	

AUG 27 1951

Orig. Date

County Kingman State Kansas
 Sec. 17 (Blk.) 28 (Sur.) 5W Map No.
 Operator E. Wakefield
 Well No. 1 Farm Broadway "B"
 Elev. 1383 Location SE SE SE

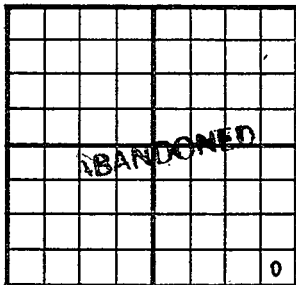

330 Ft. From S Line SE
330 Ft. From E Line Quarter
 Ist. Report
 Completion SEP 10 1952
 Remarks Broadway Pool
 Spudding Date 11-15-51

Drilg. Data SWD well TD 4864
8" @ 122 Lans. 2991 Miss. 3789
Arb. 4329 TD 4864 5" @ 4330
Comp. for SWD well

J. G. McGEHEE

Scout Cards

Land Small Map

Land Wall Map

Tracings

France Map

Pierce Map

Misc.

52-17 1952

Orig. Data