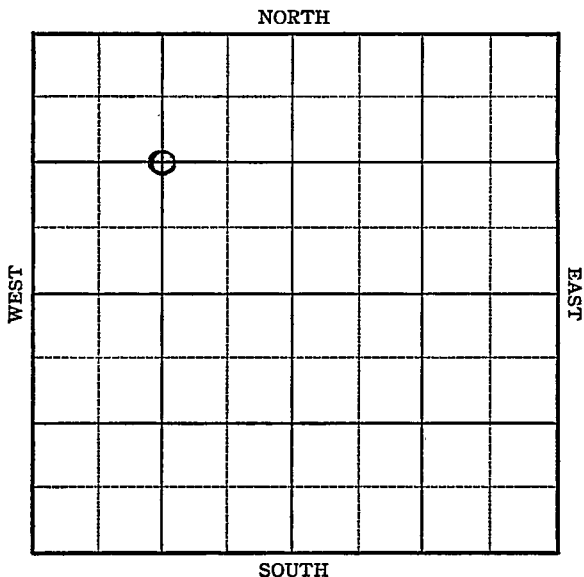


Grant

KANSAS

Section 17 Township 28 Range 37-WWell No. 1 WhitsonCompany R. K. Wilson

Grant

KANSAS

Map No. _____ Sec. 17 Twp. 28 R. 37WWell No. 1 WhitsonR. K. Wilson

Company _____

Contractor _____

FIRST REPORT

C NW


1320 Ft. from N. Line

_____ Ft. from S. Line

_____ Ft. from E. Line

1320 Ft. from W. Line

SECTION PLAT

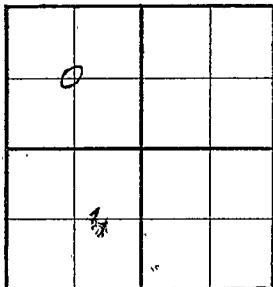

Location _____

Rig up _____

Drilling and Remarks:

RUR

RECORD

Cased _____ in., _____ ft.

Sand _____

Gas _____

Oil _____

Total Depth _____

PRODUCTION

1st 24 hrs. Nat. _____

1st 24 hrs. after shot _____

Gas _____ Cu. Ft.

Dry Hole _____

Abandoned _____

Date

OCT 13 1937 19H. D. Hatfield Scout

Grant **KANSAS**Map No. N 13 Sec. 17 Twp. 28 R. 37WWell No. 1 WhitsonR. K. Wilson

Company

Contractor

COMPLETED**C NW**1320 Ft. from N. Line

_____ Ft. from S. Line

_____ Ft. from E. Line

1320 Ft. from W. Line**SECTION PLAT**

○			

Location _____

Rig up _____

Drilling and Remarks:

shot 550 gts7 M**RECORD**Cased 7 in., 2641 ft.Sand ?

Gas _____

Oil _____

Total Depth 2685**PRODUCTION**

1st 24 hrs. Nat. _____

1st 24 hrs. after shot _____

Gas _____ Cu. Ft.

Dry Hole _____

Abandoned _____

Date

NOV 23 1937 19 H. D. Hatfield Scout