


Section 17 Township 28 Range 33-W

Well No. #1 Converse

Company National Assoc. Pet.

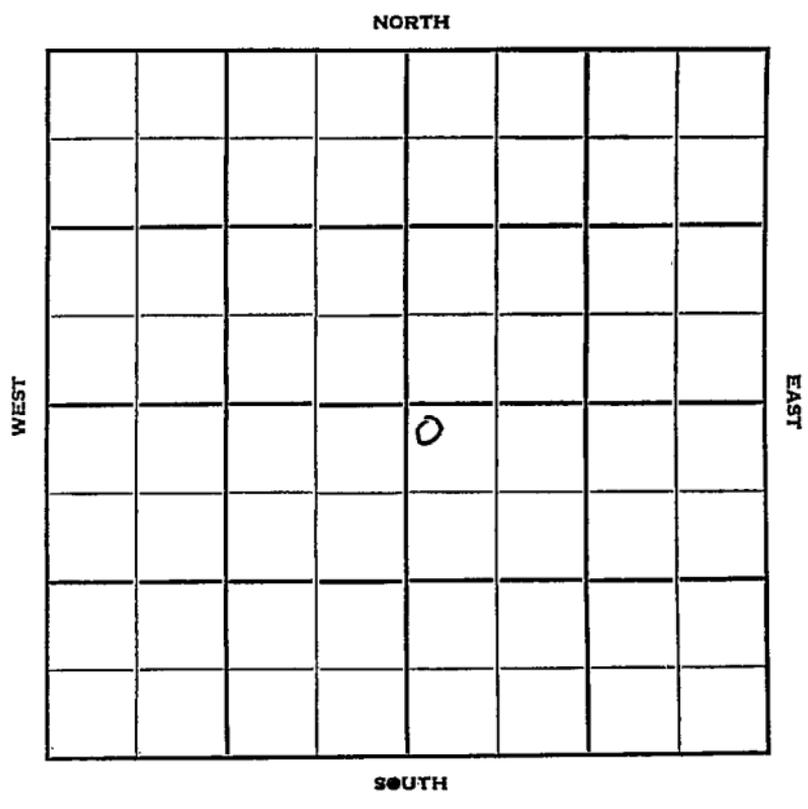

Sec. 17 Twp. 28 R. 33W ✓

Well No. #1 Converse Farm

National Assoc. Pet. Company

Burris - Contr. Contractor

Hugoton Pool


100' Ft. from N. Line

\_\_\_\_\_ Ft. from S. Line

\_\_\_\_\_ Ft. from E. Line

100' Ft. from W. Line

NW SE

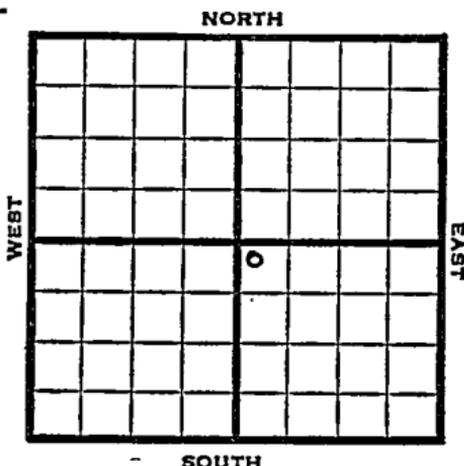

1950 Elev. 2988 REPORT

11/15 Spud 10-27-50  
Loc.

1951

2/21 Spud 10-27-50  
Gas Well TD 2767  
10" @ 600' 5" @ 2738  
TD 2767 Kri 2687  
Win 2731 132/2688-2710  
20,500 A Comp. 15,200,000 gas  
400 #

**COMPLETED**



