

KANSAS

Stanton


Section 17 Township 28 Range 39WWell No. 1 HornerCompany Stanolind

Hugoton

NORTH

WEST

EAST

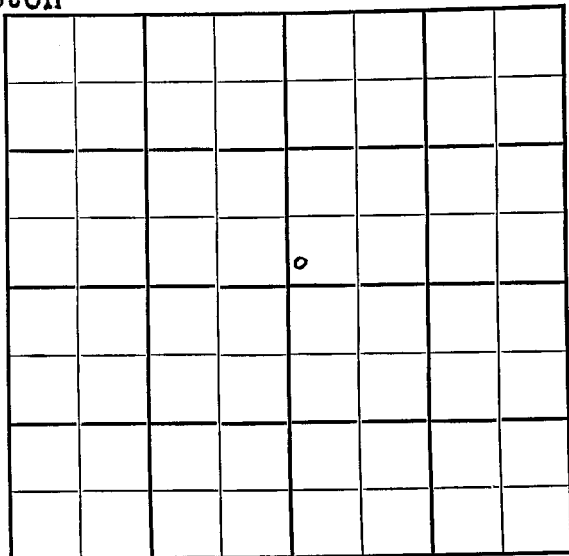


SOUTH

Sec. 17 Twp. 28 R. 39WWell No. #1 Horner Farm
Stanolind Company

Hugoton

 Ft. from N. Line150 Ft. from S. Line Ft. from E. Line150 Ft. from W. Line

SW NE

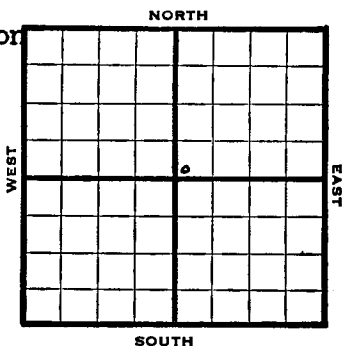

947

Elev. 5186' REPORT

10/22 RUR

10/29 10" @ 739'

TD 2675'

7" @ 2628'

RUST

1/12 7" @ 2498'

224' of 5" Perf liner @ 2575'

16,000 Acid

1,690,000 Gas

Rock Pressure 415#

Total Depth 2575'

COMPLETED

Map No. _____ Sec. 17 Twp. 28 R. 39W

Well No. 1 Horner

Stanolind Company

FIRST REPORT Contractor

SW NE

SECTION PLAT

		o	

_____ Ft. from N. Line

150 Ft. from S. Line

_____ Ft. from E. Line

150 Ft. from W. Line

Stanton County

Location _____

Rig up _____

Drilling and Remarks:

RUR

RECORD

Cased _____ in., _____ ft.

Sand _____

Gas _____

Oil _____

Total Depth _____

PRODUCTION

1st 24 hrs. Nat. _____

1st 24 hrs. after shot _____

Gas _____ Cu. Ft.

Dry Hole _____

Abandoned _____

Date

OCT 22 1947 19

S. J. LEWIS Scout

Map No. ✓ Sec. 17 Twp. 28 R. 39W

Well No. 1 Horner

Stanolind


Company

COMPLETE

Contractor

SW NE

E1,3186
SECTION PLAT

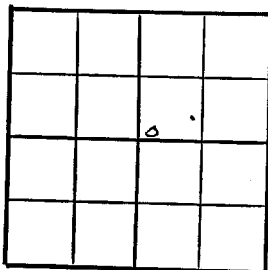

 Ft. from N. Line

150 Ft. from S. Line

 Ft. from E. Line

150 Ft. from W. Line

Stanton County

Location

Rig up

Drilling and Remarks:

7" C2498.
224' x 5" Prof liner
C2525.
16000 acid
1,690,000 Gas
415* R/P

RECORD

Cased in., ft.

Sand

Gas

Oil

Total Depth 2525

PRODUCTION

1st 24 hrs. Nat.

1st 24 hrs. after shot

Gas Cu. Ft.

Dry Hole

Abandoned

Date

NOV 1 2 1947

19

S. J. LEWIS

Scout