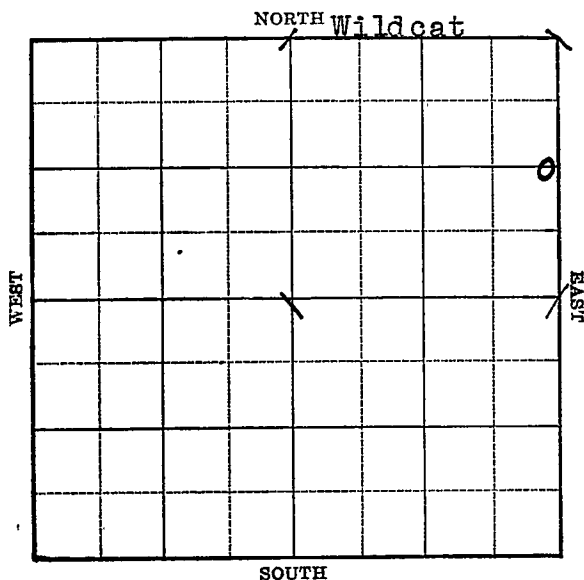


Section 17 Township 28 Range 11-WWell No. #1 E. S. GrosleyCompany Skelly

KANSAS


Pratt

Sec. 17 Twp. 28 R. 11-WWell No. #1 E. S. Crosley FarmSkelly Company

(\$Wildcat)

1328 Ft. from N. Line Ft. from S. Line50 Ft. from E. Line Ft. from W. Line

Elev. 1815

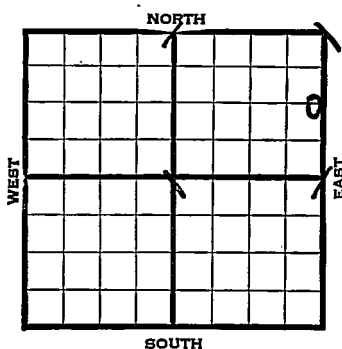

1939	REPORT	4411 1815 5596
8/2	Rotary.	
8/10	10" - 342' Drlg. 1630'	
8/17	Drlg. 2745'	
8/24	Lans. 3641' Porous & saturation 3672-77'	
	Drlg. 3850'	
8/31	Viola 4303' 5" - 4304'	
	T.D. 4306' WOC.	
9/7	Drlg. 4353' No shows.	
9/14	Simp. 4411' H.F.O. T.D. 4416'	
9/21	P. B. 4337' Shot 40 qts. 4316- 4336'	
9/27	Viola 4303'	
	5" - 4304'	
	T.D. 4416'	
	Shot 40 qts. 4316-36'	
	Trace gas.	
	ABANDONED	

Map No. 54 Sec. 17 Twp. 28 R. 11WWell No. 1 E. S. CrosleySkelly

Company

Contractor

FIRST REPORT

C E L N E

1328 Ft. from N. Line Ft. from S. Line50 Ft. from E. Line Ft. from W. Line

SECTION PLAT

			0

WILDCAT

Location Rig up

Drilling and Remarks:

Rotary

RECORD

Cased in., ft.Sand Gas Oil Total Depth

PRODUCTION

1st 24 hrs. Nat. 1st 24 hrs. after shot Gas Cu. Ft.Dry Hole Abandoned

Date

AUG 2 193919S. J. LEWIS

Scout

Pratt

KANSAS

Map No. 54 Sec. 17 Twp. 28 R. 11WWell No. 1 E. S. Crosley

Skelly


Company

Contractor

ABANDONED
C E L NE1328 Ft. from N. Line Ft. from S. Line50 Ft. from E. Line Ft. from W. Line

WILDCAT

SECTION PLAT

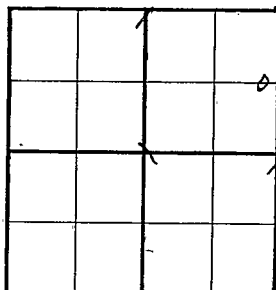Location Rig up

Drilling and Remarks:

*Viola 4303**5" @ 4304**Shot 409 to 4316-36*
trace gas.

RECORD

Cased in., ft.Sand Gas Oil Total Depth 4416

PRODUCTION

1st 24 hrs. Nat. 1st 24 hrs. after shot Gas Cu. Ft.Dry Hole Abandoned

Date

SEP 27 1939

19

S. I. LEWIS

Scout