

KANSAS

Kingman county ✓

Sec. 17 Twp. 28 R. 9W


Well No. 1 Albritten Farm
Aylward Prod.
Company

Pat Creek Pool
330 Ft. from N. Line

_____ Ft. from S. Line

330 Ft. from E. Line

_____ Ft. from W. Line

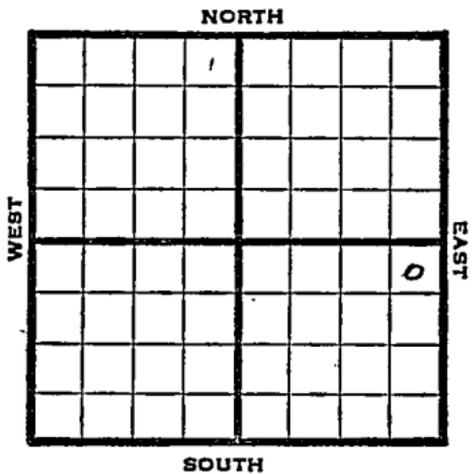

NE SE

1947 Elev. 1656' REPORT

5/7 Location

5/13 "

5/20 RUR

5/27 8" @ 205'
Drlg. 2400'

6/3 Lansing 3510
Miss 4051
Drlg. 4185'

6/11 Arb. 4511'
TD 4514'

ABANDONED

Map No. K36 Sec. 17 Twp. 28 R. 9W

Well No. 1 Albritten

Aylward Prod. Company

FIRST REPORT Contractor

NE SE


SECTION PLAT

330 Ft. from N. Line

 Ft. from S. Line

330 Ft. from E. Line

 Ft. from W. Line

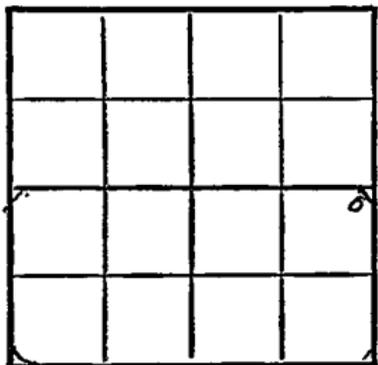

Kingman County

Location X

Rig up

Drilling and Remarks:

RECORD

Cased in. ft.

Sand

Gas

Oil

Total Depth

PRODUCTION

1st 24 hrs. Nat.

1st 24 hrs. after shot

Gas Cu. Ft.

Dry Hole

Abandoned

Date

MAY 7 1947

S. J. LEWIS Scout

Map No. 36 Sec. 17 Twp. 28 R. 9W

Well No. 1 Albritten

Aylward Prod. Company

ABANDONED Contractor

NE SE

E 1/1656
SECTION PLAT

330 Ft. from N. Line

_____ Ft. from S. Line

330 Ft. from E. Line

_____ Ft. from W. Line

			6

Kingman County

Location _____

Rig up _____

Drilling and Remarks:

Per 4511

RECORD

Cased _____ in., _____ ft.

Sand _____

Gas _____

Oil _____

Total Depth 4514

PRODUCTION

1st 24 hrs. Nat. _____

1st 24 hrs. after shot _____

Gas _____ Cu. Ft.

Dry Hole _____

Abandoned _____

Date

JUN 11 1947 19

S. J. LEWIS Scout